


T.21S.R.5W.W.M.

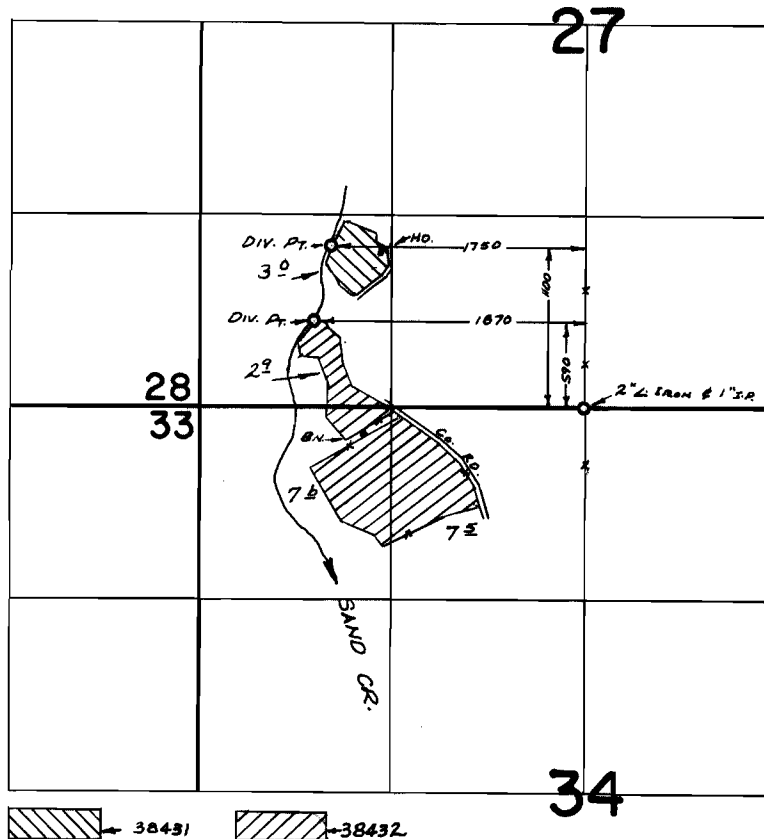

FINAL PROOF SURVEY
UNDER

Application No. ³⁸⁴³¹~~38432~~ Permit No. ²⁸⁷⁰⁸~~28709~~
IN NAME OF

G. KEITH & DORIS ROBERTS

Surveyed JUNE 2, 1970, by R. MUCKEN