


# T.28S.R.7W.W.M.

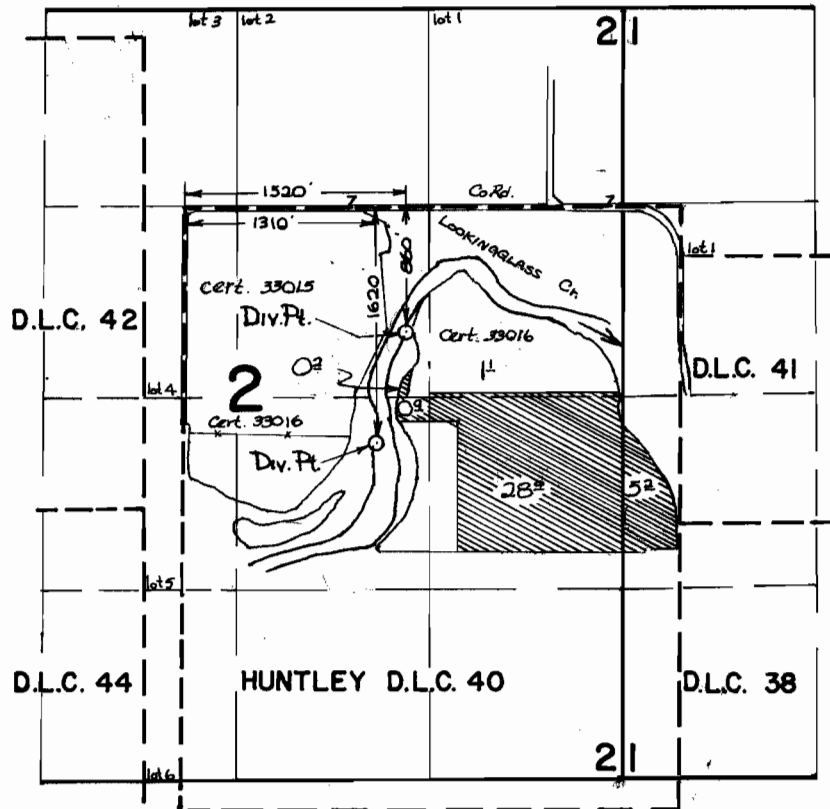

## FINAL PROOF SURVEY

UNDER

Application No. 41161 Permit No. 30686

IN NAME OF

FRED C. SCHULTZE

Surveyed 18 JUNE 1970, by D. R. BUELL