


T.27S.R.5W.W.M.

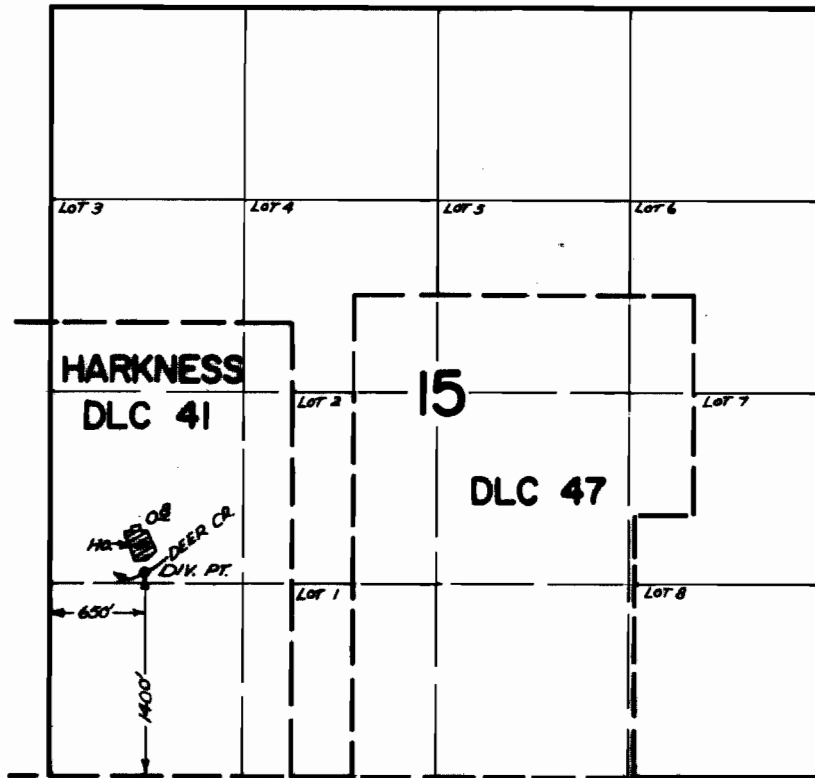

FINAL PROOF SURVEY
UNDER

Application No. 41264 Permit No. 30771
IN NAME OF

CARL E. ROSELUND

Surveyed SEPT. 30, 1970, by L.E. GOULD