


T.21S.R.4W.W.M.

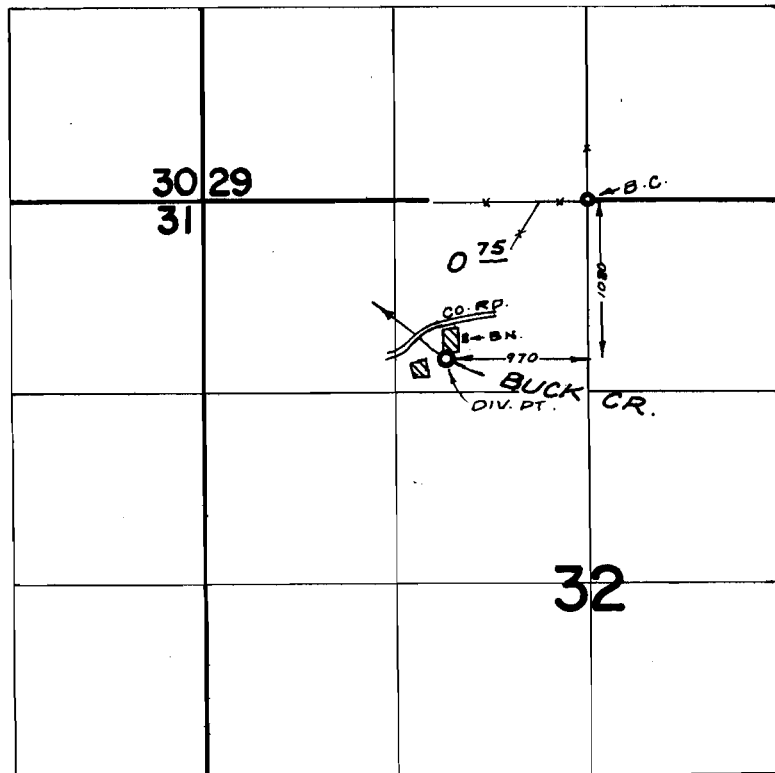

FINAL PROOF SURVEY

UNDER

Application No. 41547 Permit No. 30992

IN NAME OF

ROBERT A. PERINI

Surveyed JUNE 18, 1970, by R. MUCKEN