


T.22S.R.6W.W.M.

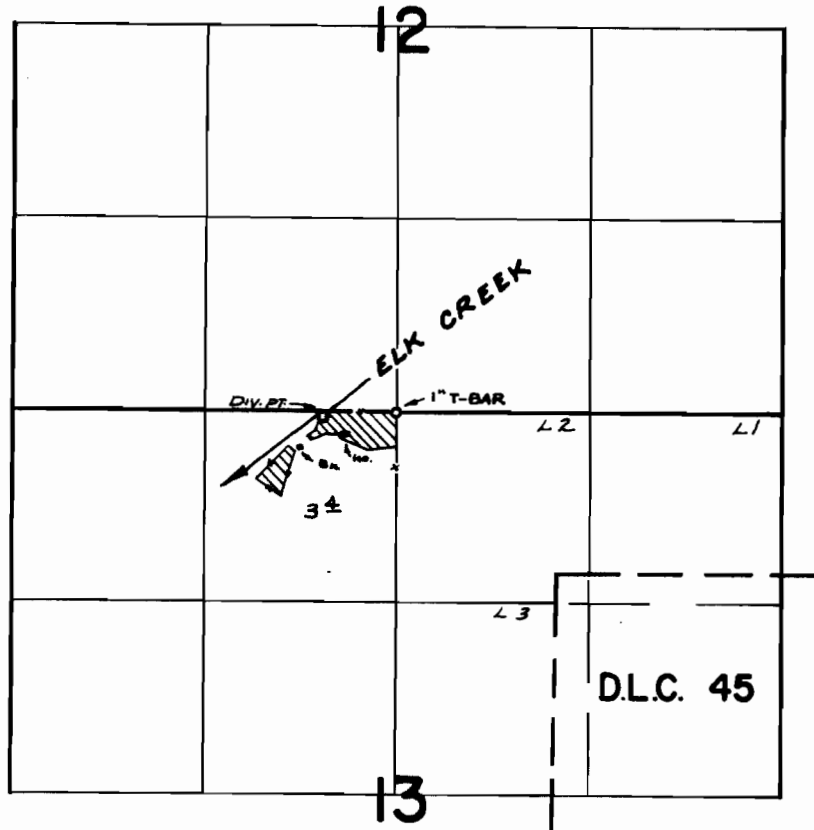

FINAL PROOF SURVEY
UNDER

Application No. 42574 Permit No. 31012
IN NAME OF

THOMAS E. & EUNICE M. PLUMB

Surveyed JUNE 9, 1970, by R. MUCKEN