


T.22 S.R.5W.W.M.

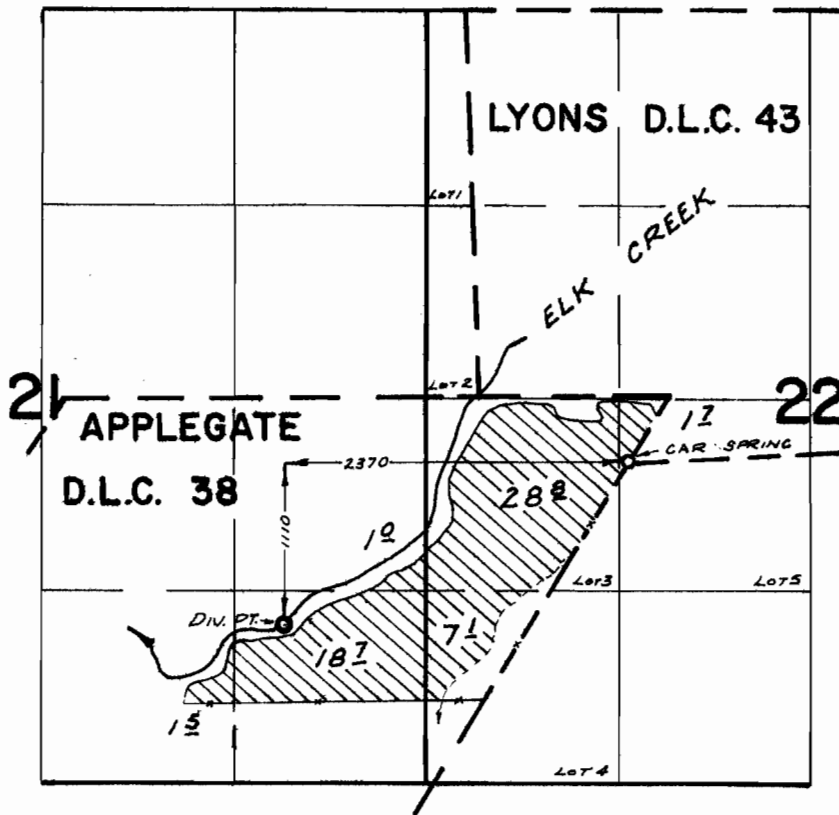

FINAL PROOF SURVEY

UNDER

Application No. 43600 Permit No. 32654

IN NAME OF

GEORGE CHURCHILL

Surveyed JUNE 16 19 70, by R. MUCKEN