


# T.22S.R.5W.W.M.

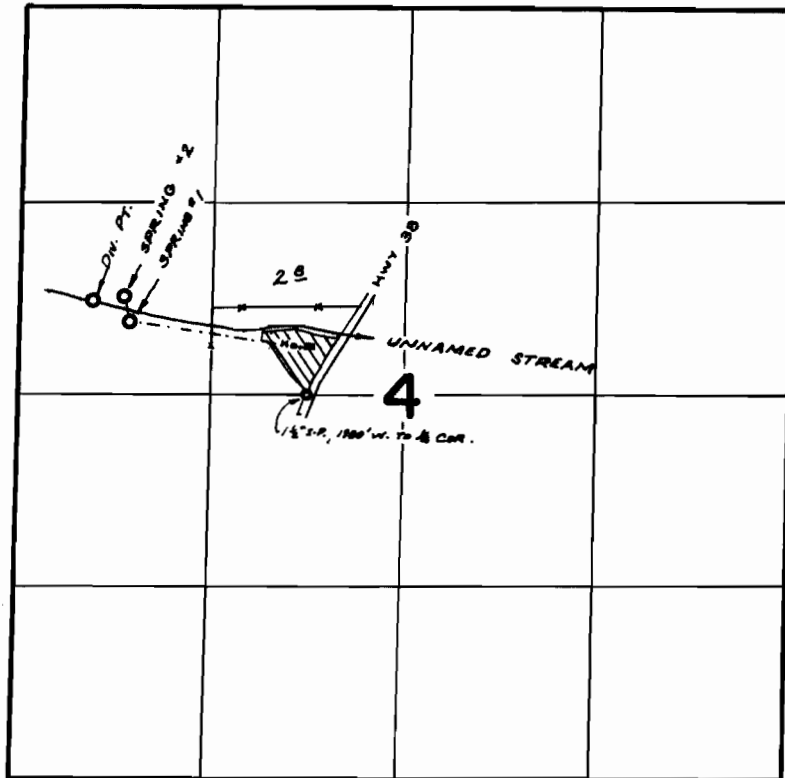

DIV. PT. LOC: 520'E & 640'N, SPRING #1 LOC: 770'W & 500'N,  
SPRING #2 LOC: 730'E & 670'N; ALL FROM W. 1/4 COR. SEC. 4

## FINAL PROOF SURVEY UNDER

Application No. 45065 Permit No. 33130  
IN NAME OF

W. J. & N. D. SAGABERD

Surveyed JUNE 1, 1970, by R. MUCKEN