


T.22S.R.5W.W.M.

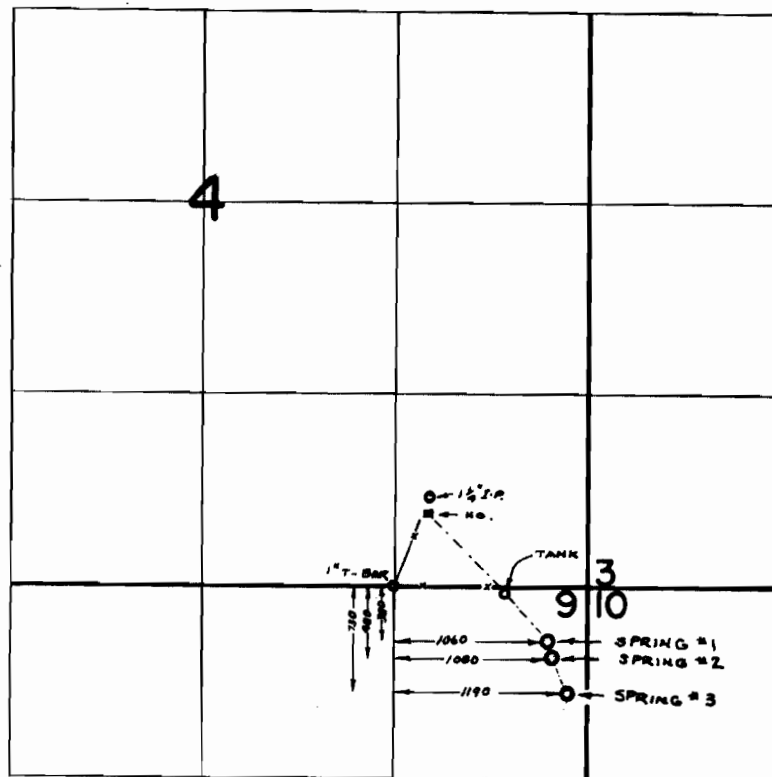

FINAL PROOF SURVEY
UNDER

Application No. 45285 Permit No. 33816
IN NAME OF

FLOYD REEL

Surveyed JUNE 5, 1970, by R. MUCKEN