


P-32494 6
37916

T.IN.&IS.R.2IE.W.M.

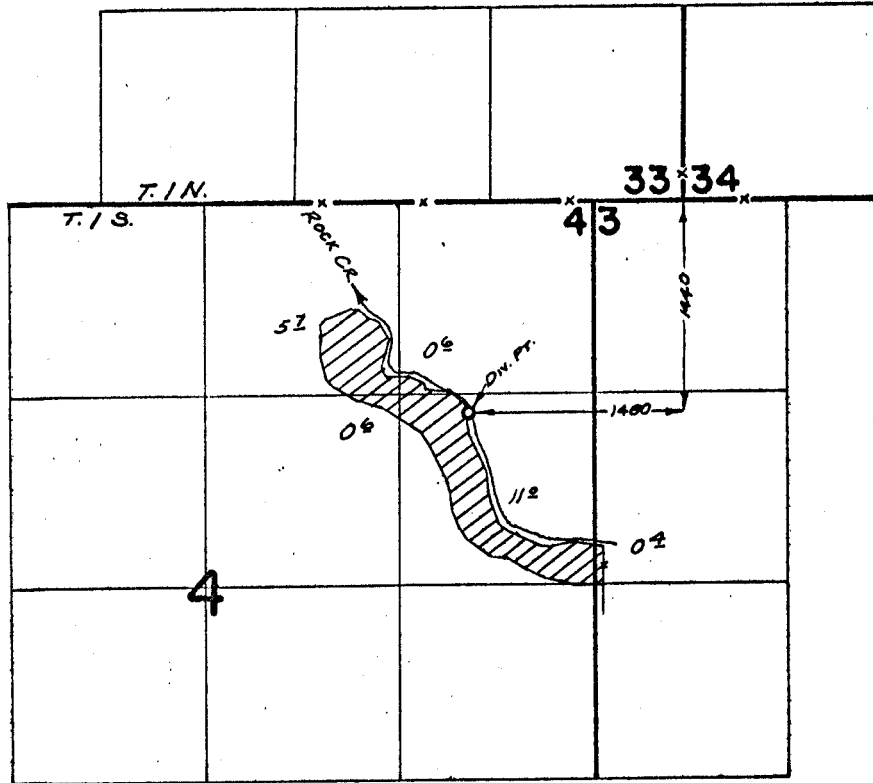

FINAL PROOF SURVEY

UNDER

Application No. 43307... Permit No. 32494...

IN NAME OF

HERMAN & CAROLINE STEINKE TRUST

Surveyed Oct. 28, 1970, by R. MUCKEN