


T.33S.R.6W.W.M.

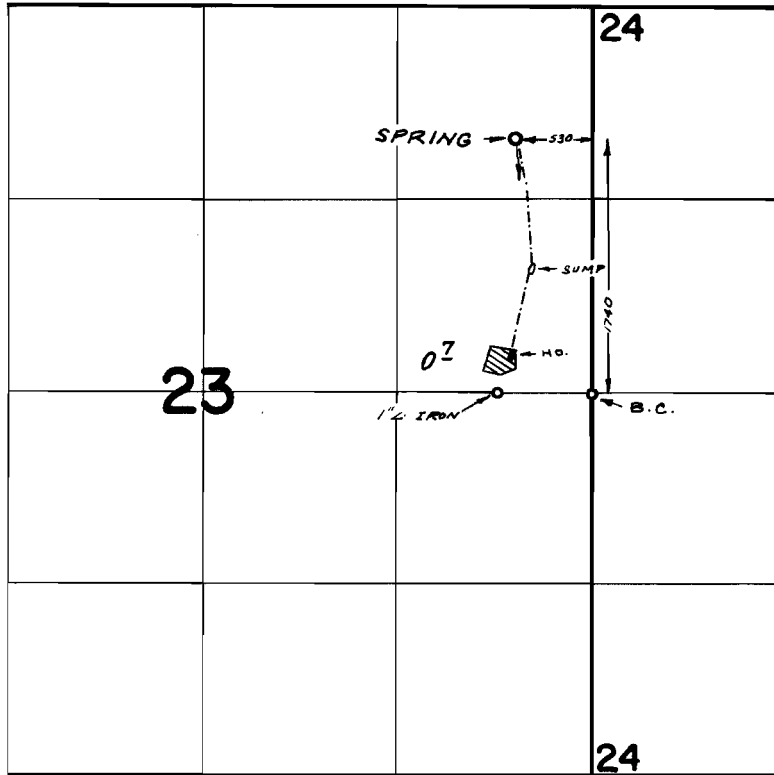

FINAL PROOF SURVEY UNDER

Application No. 29940 Permit No. 29727
IN NAME OF

LESLIE L & MARY L. COX

Surveyed APR. 28, 1970, by R. MUCKEN