


T. 36 S. R. 6 W. W. M.

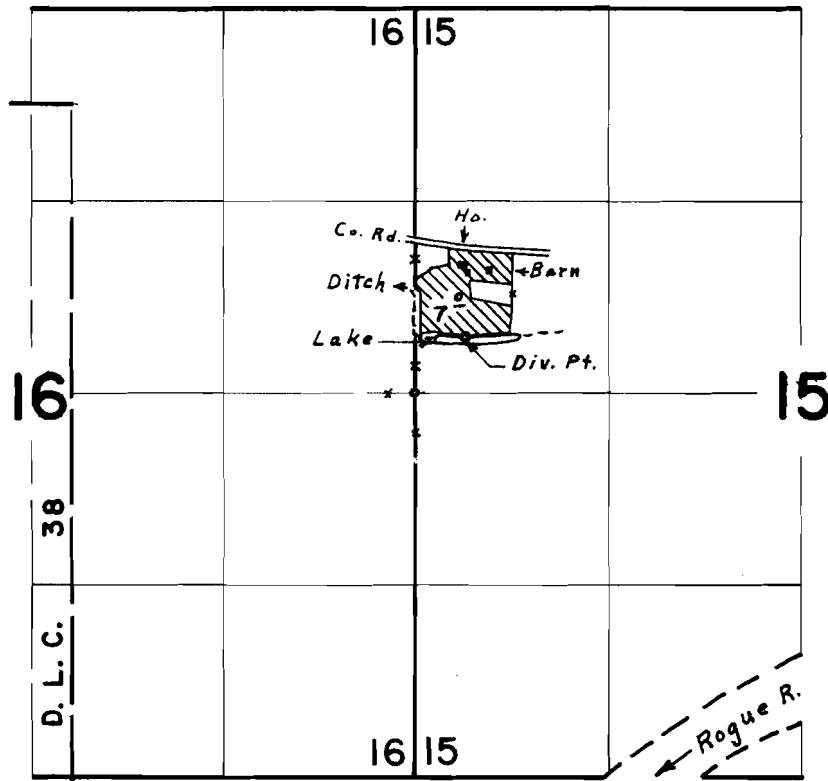

Div. Pt. located 380' N. & 340' E. from W. $\frac{1}{4}$ Cor. Sec. 15

FINAL PROOF SURVEY

UNDER

Application No. 42056 Permit No. 31480

IN NAME OF

SALVATORE JOHN & CATHERINE FULCO

Surveyed April 30 1970, by L. E. Gould