


T. 34 & 35 S. R. 8 W. W. M.

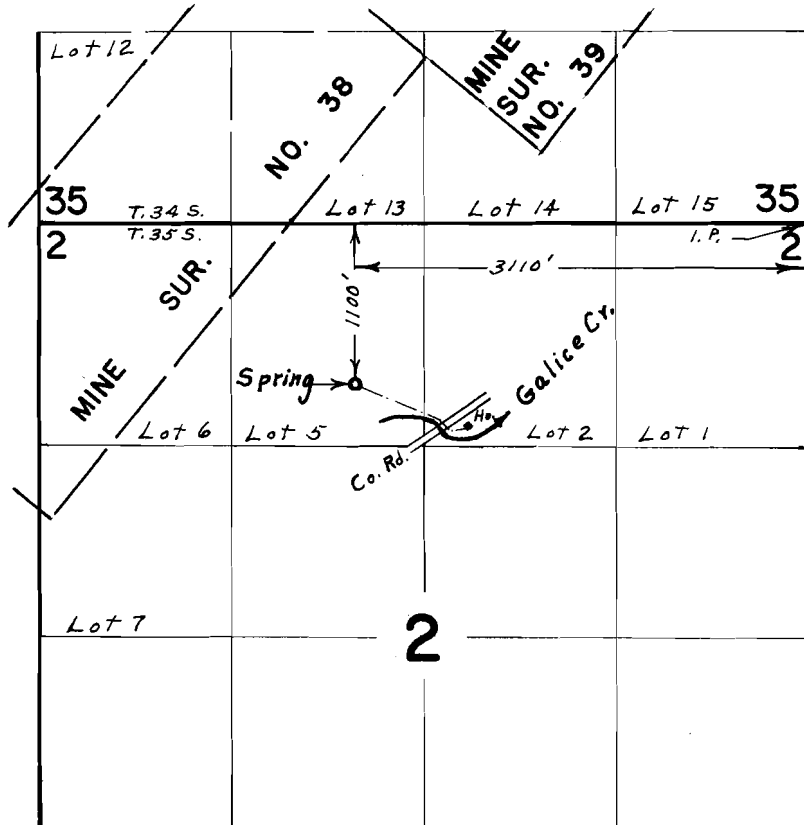

FINAL PROOF SURVEY

UNDER


Application No. 44053 Permit No. 32920

IN NAME OF

NORMAN G. & LUCILLE (ROBERTSON) BORRESON

Surveyed April 28, 1970, by L. E. Gould

T. 34 & 35 S. R. 8 W. W. M.

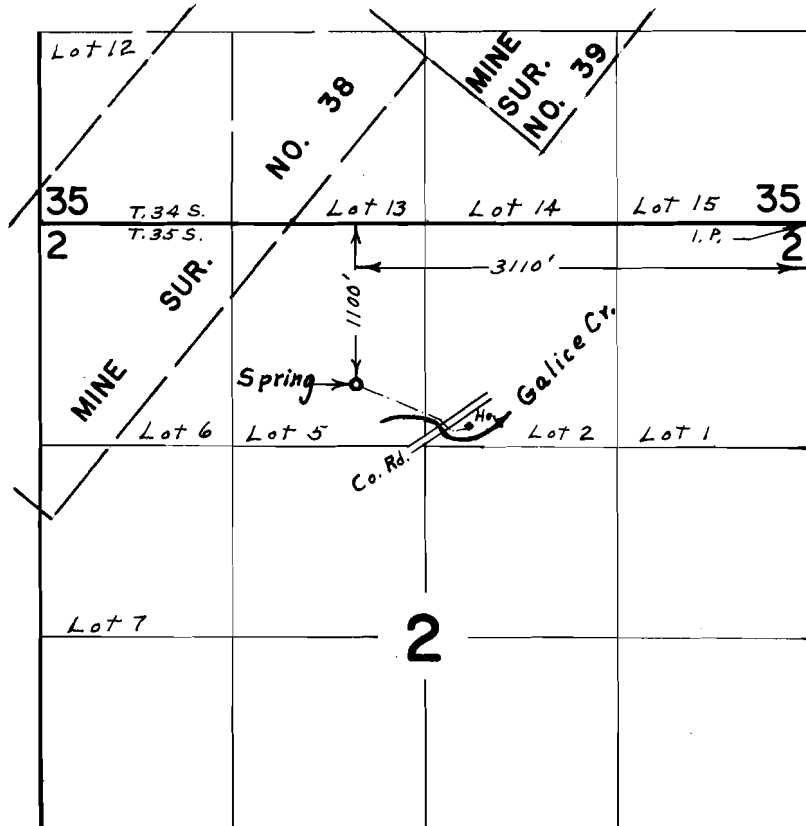

FINAL PROOF SURVEY

UNDER

Application No. 44053 Permit No. 32920

IN NAME OF

NORMAN G. & LUCILLE (ROBERTSON) BORRESON

Surveyed April 28, 1970, by L. E. Gould