


T. 35 S. R. 7 W. W. M.

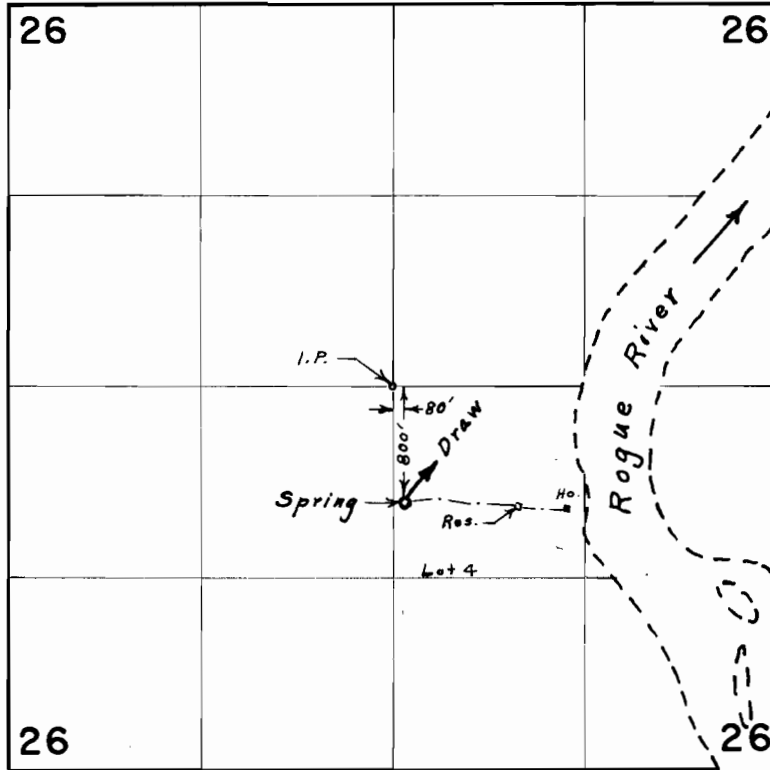

FINAL PROOF SURVEY

UNDER

Application No. **45030** Permit No. **33656**

IN NAME OF

**EDWIN S. CRAM**

Surveyed **April 27, 1970**, by **L. E. Gould**.