


G-3204  
14  
37923

# T.40S.R.11E.W.M.

East R. Wells

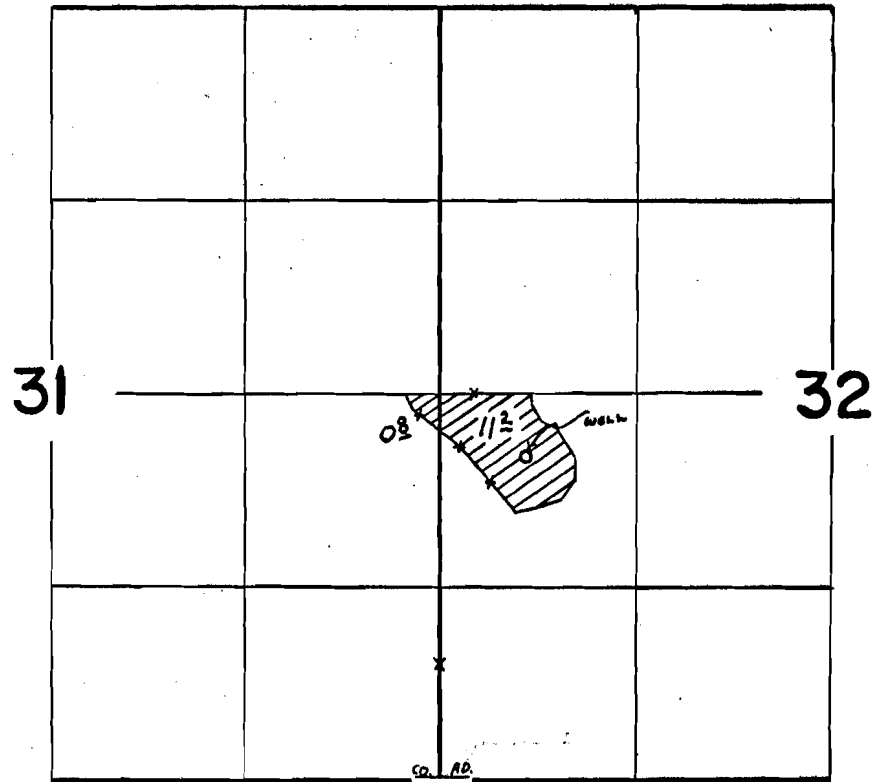

WELL LOCATED 2220' N & 670' E OF SE COR. SEC. 22

## FINAL PROOF SURVEY UNDER

Application No. G-3418 Permit No. G-3204  
IN NAME OF

MARVIN RETTERATH

Surveyed SEPT. 16, 1970, by G. BACA