


G-3427 14
37924

T.38S.R.11E.W.M.

Bucke Cr. & Janna Valley wells

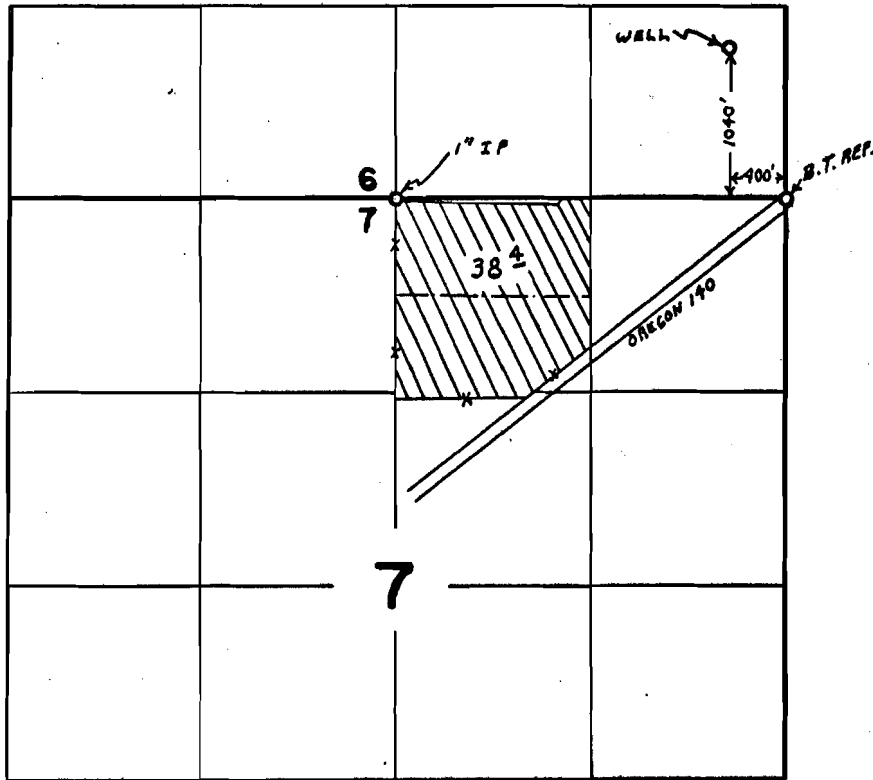

FINAL PROOF SURVEY UNDER

Application No. G-3648 Permit No. G-3427
IN NAME OF

BERNARD J. JENDRZEJEWSKI

Surveyed SEPT. 18 1970, by G. BALCA