


Big Springs c.k. rise

~~30051~~
30051
37927

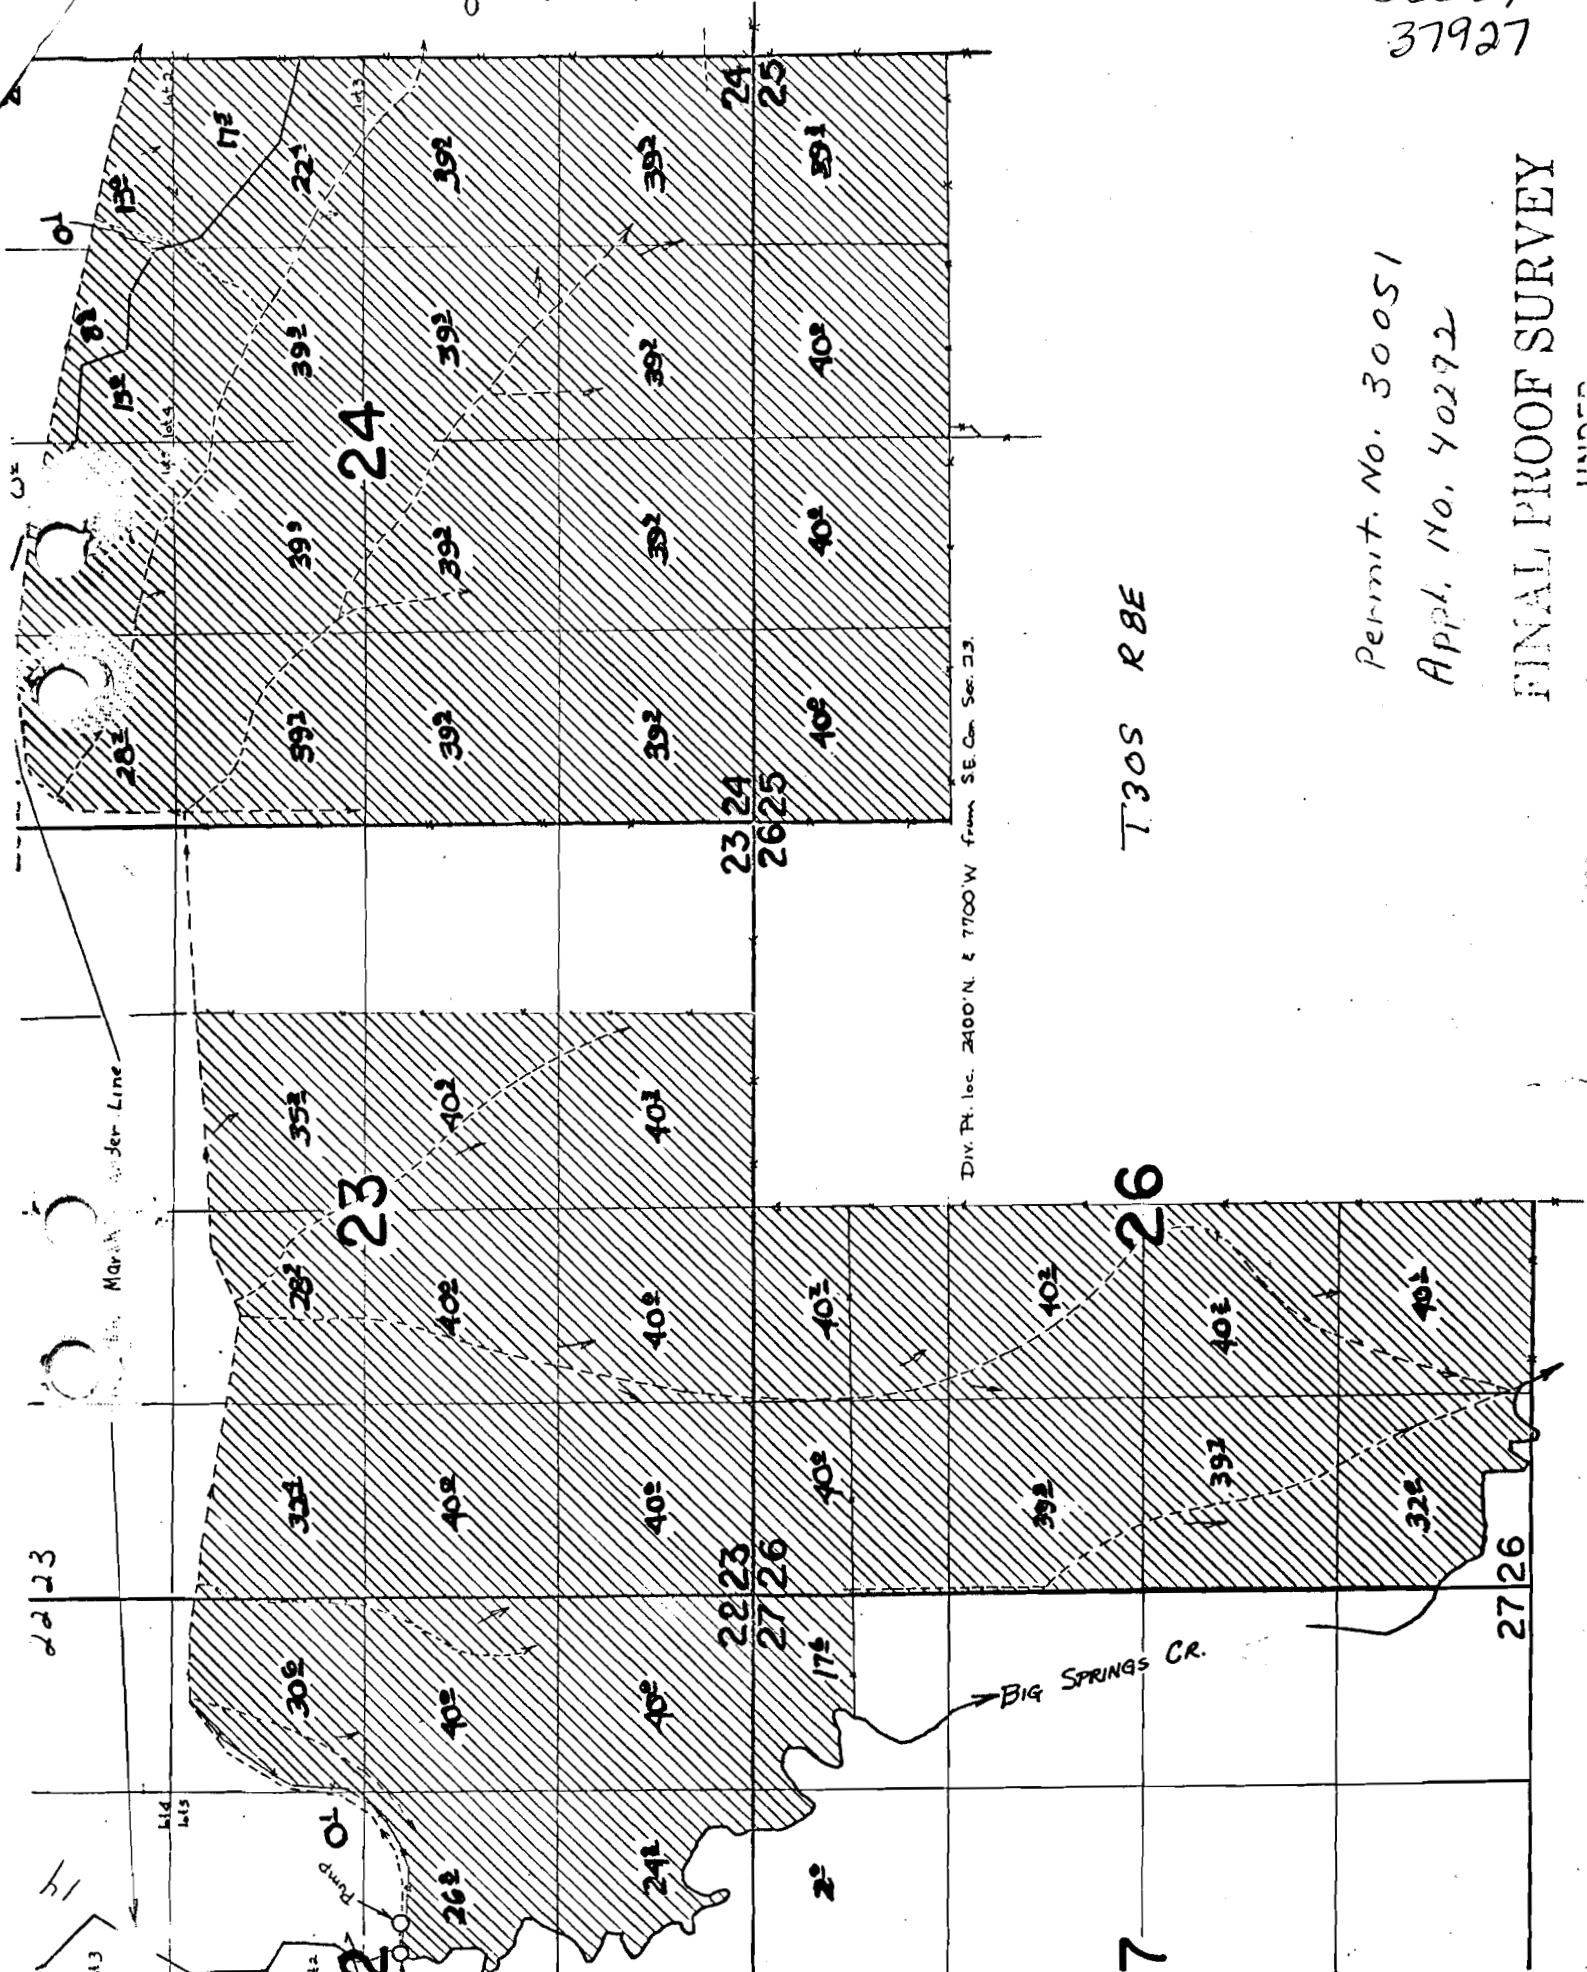

Div. Pt. loc. 3400' N. & 7700' W. from S.E. Cor. Sec. 23.

T30S R8E

Permit. No. 30051
Appl. No. 40292

FINAL PROOF SURVEY

