


T. 15 S. R. 4 W. W. M.

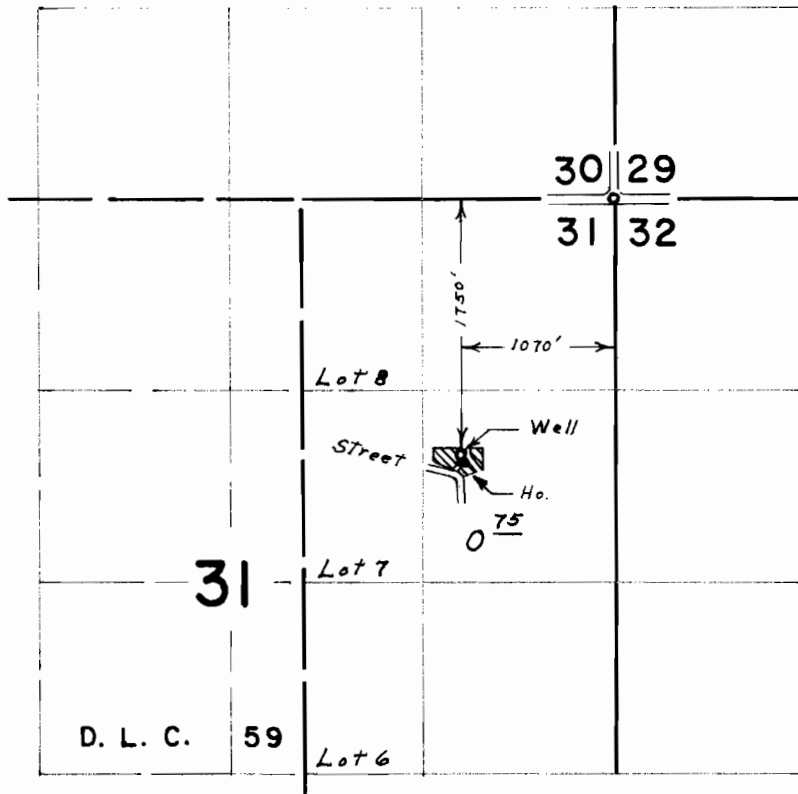

FINAL LEGAL SURVEY

PLAT

Book G-3547 Page G-3336

IN NAME OF

STANLEY B. HALL

Surveyed June 9, 1970 by L. E. Gould