


T.17S.R.2W.W.M.

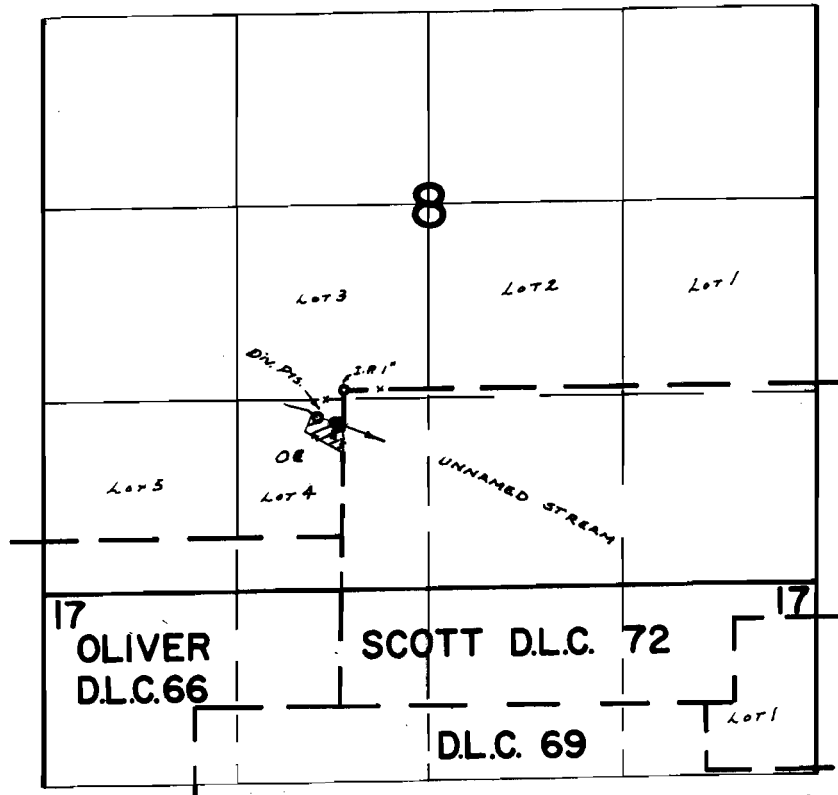

Div. Pts. Loc: 14055' 180°W; 220' S & 60°W; Both From N.W. Cor. Scott D.L.C. 72

FINAL PROOF SURVEY

UNDER

Application No. 39143 Permit No. 29127

IN NAME OF

L. M. & GOLDEN SIEVERSON

Surveyed Nov. 12, 1970, by R. MUCKEN