


T.17S.R.1W.W.M.

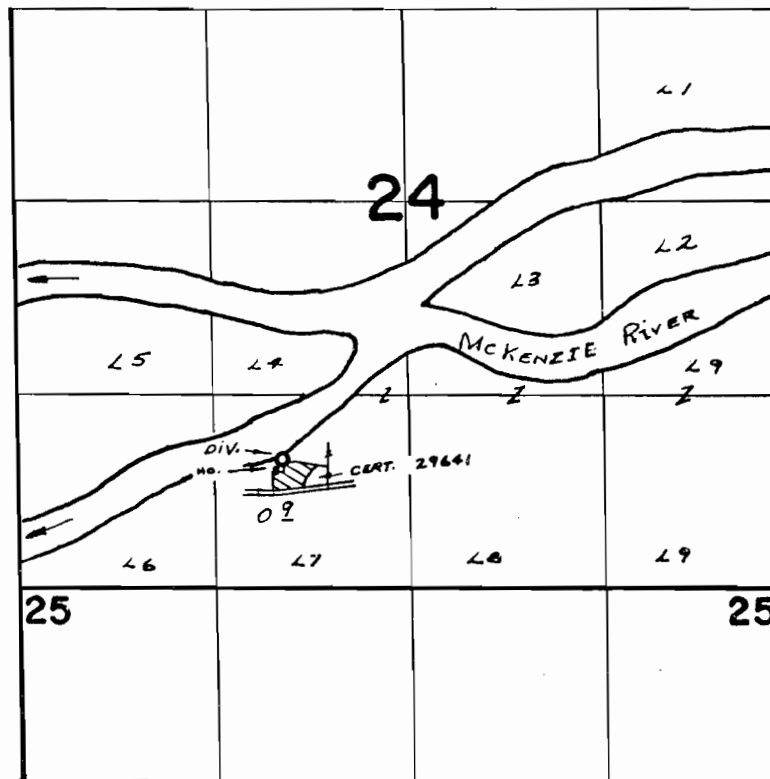

DIV. PT. LOC: 880' N & 870' W. FROM S. 1/4 COR. SEC. 24

FINAL PROOF SURVEY

UNDER

Application No. 41387 Permit No. 30915

IN NAME OF

MERVIN B. & LISETTA A. VATER

Surveyed Oct. 14, 1970, by R. MUCKEN