


# T.17 S.R.1W. W.M.

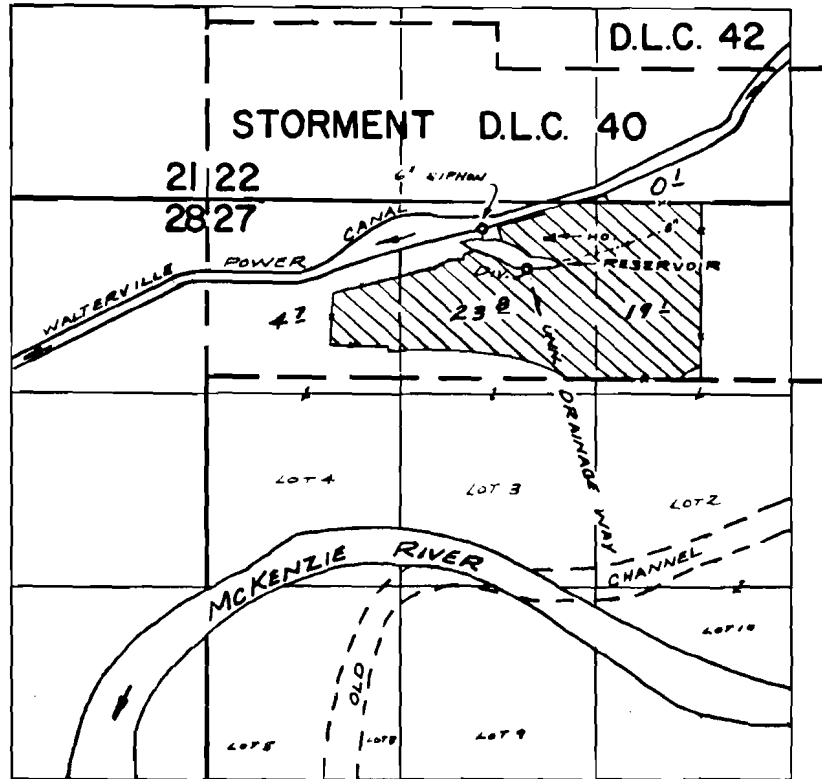

DIV. PTS. LOC: W.P.C. - LOT 1 (NE 1/4 SE 1/2) SEC. E3; RE-DIV FROM W.P.C. - 180' E. 180'S; RES. DIV - 2160' E. f 460'S., BOTH FROM N.W. COR. SEC. 27

## FINAL PROOF SURVEY UNDER

Application No. 41441 R-42579 Permit No. 31785 R-4993  
IN NAME OF

JACK CRAWFORD

Surveyed 067.15, 1970, by R. MUCKEN.