


T.18S.R.2W.W.M.

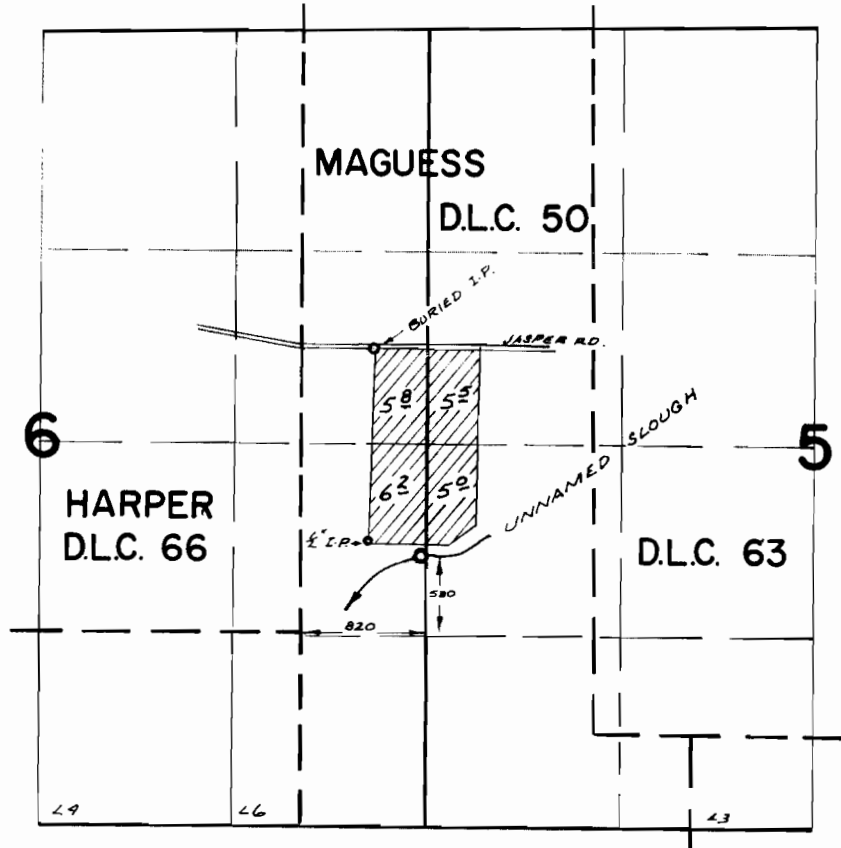

FINAL PROOF SURVEY UNDER

Application No. 42958 Permit No. 32093
IN NAME OF

JOE GRECO

Surveyed Nov. 16, 1970, by R. MUCKEN.