


T.17S.R.IW.W.M.

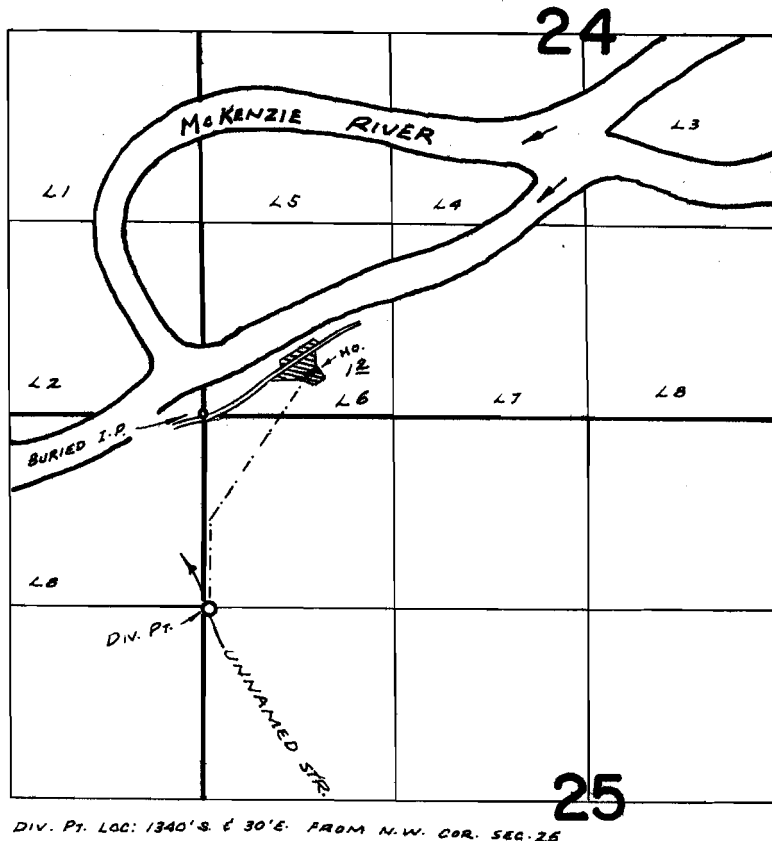

FINAL PROOF SURVEY

UNDER

Application No. 44261 Permit No. 32605

IN NAME OF

KERMIT B. SCOTT

Surveyed OCT. 13 19 70 by R. MUGKEN