


T. 15 S. R. 1 W. W. M.

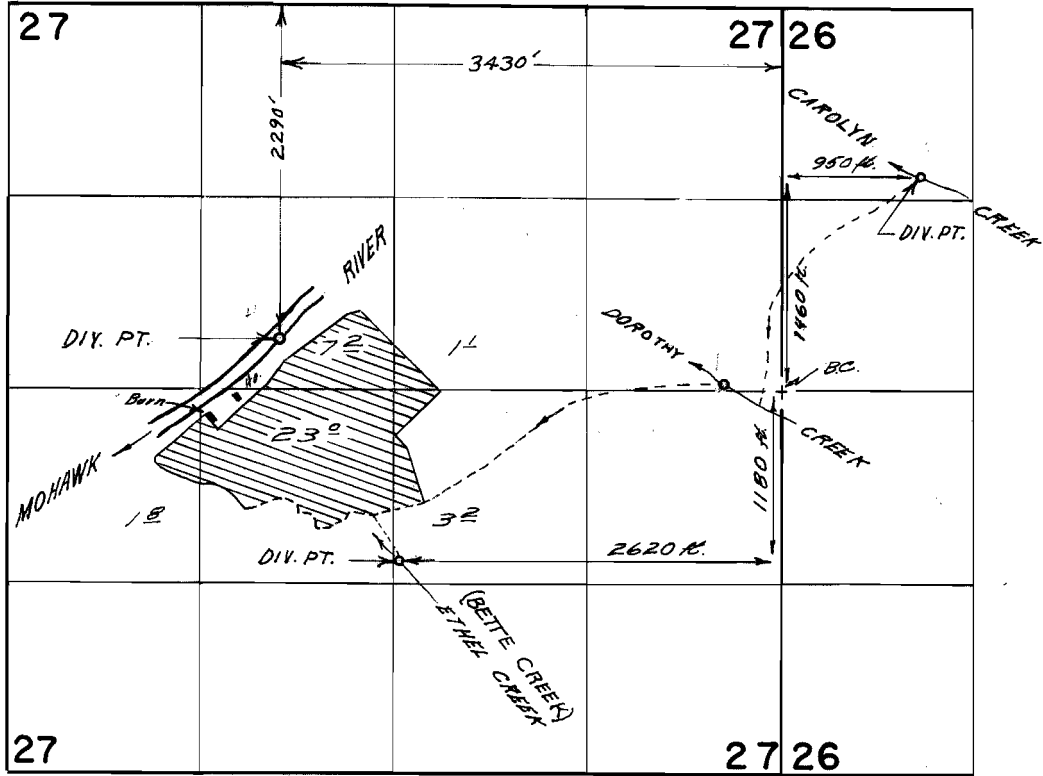

FINAL PROOF SURVEY UNDER

Application No. 43947. Permit No. 32835
IN NAME OF

BLACK HAWK RANCH

Surveyed Sept. 14, 1967, by W. J. Ruppert
June 16, 1970 by L. E. Gould