


T.17S.R.IW.W.M.

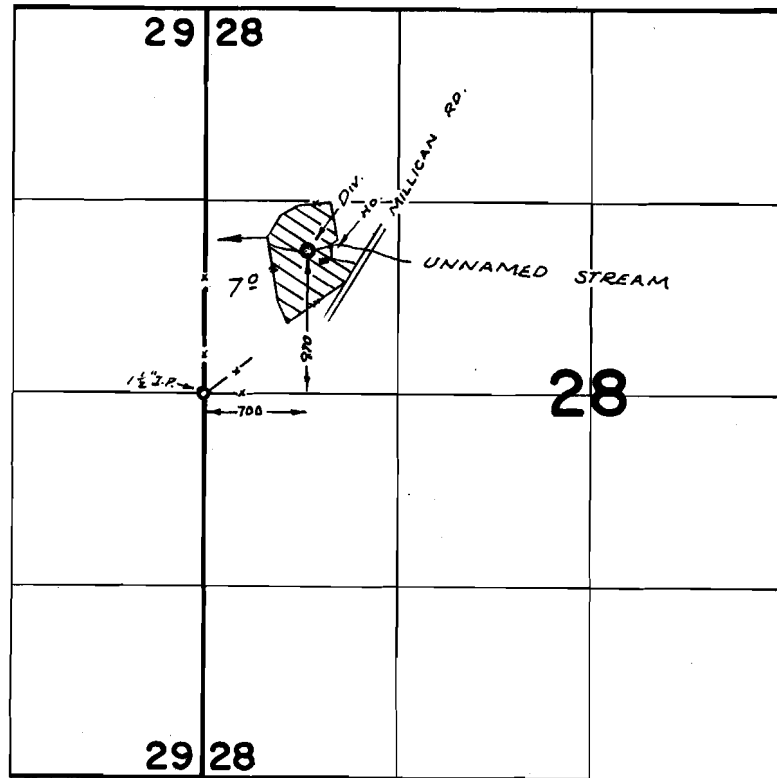

FINAL PROOF SURVEY

UNDER

Application No. 44028 Permit No. 32909

IN NAME OF

KEITH BEDORTHA

Surveyed OCT. 13, 1970, by R. MUCKEN