


T.17S.R.IW.W.M.

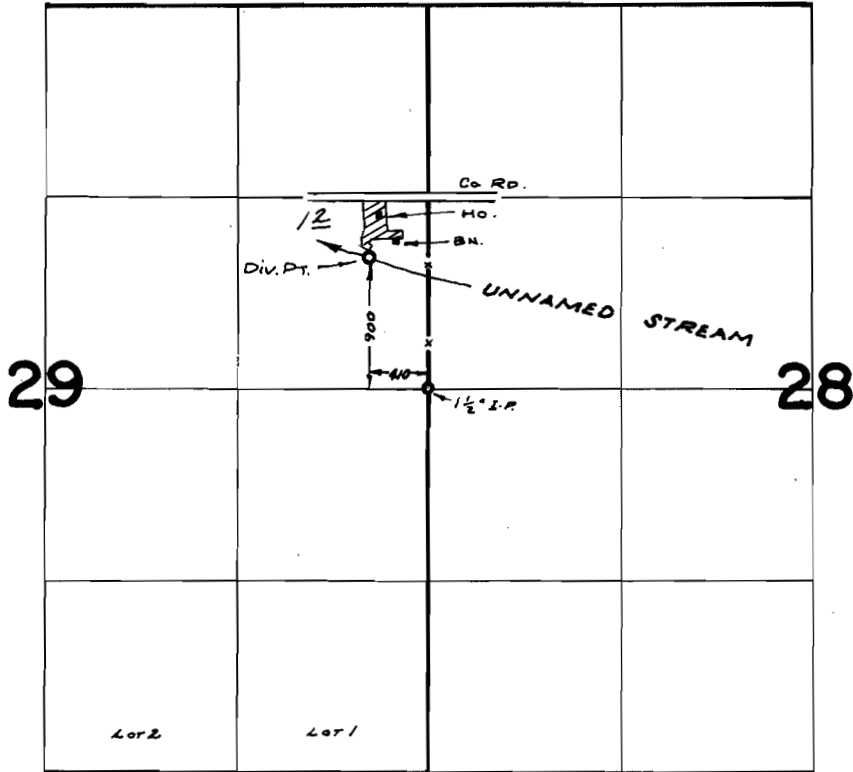

FINAL PROOF SURVEY

UNDER

Application No. 44038 Permit No. 32913

IN NAME OF

JESSE C. SCHWERING

Surveyed OCT. 16, 1970, by R. MUCKEN