


T.17S.R.1W.W.M.

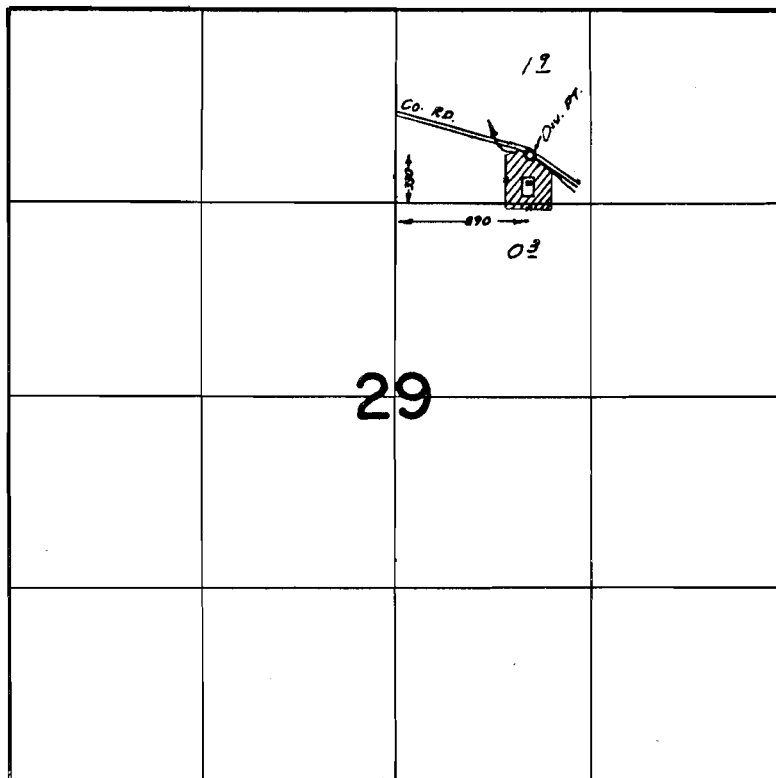

FINAL PROOF SURVEY

UNDER

Application No. 44030 Permit No. 33338

IN NAME OF

CLEO M. & WILLARD R. HAMMERSLAND

Surveyed Oct. 13, 1970, by R. MUCKEN