


T.17S.R.IW.W.M.

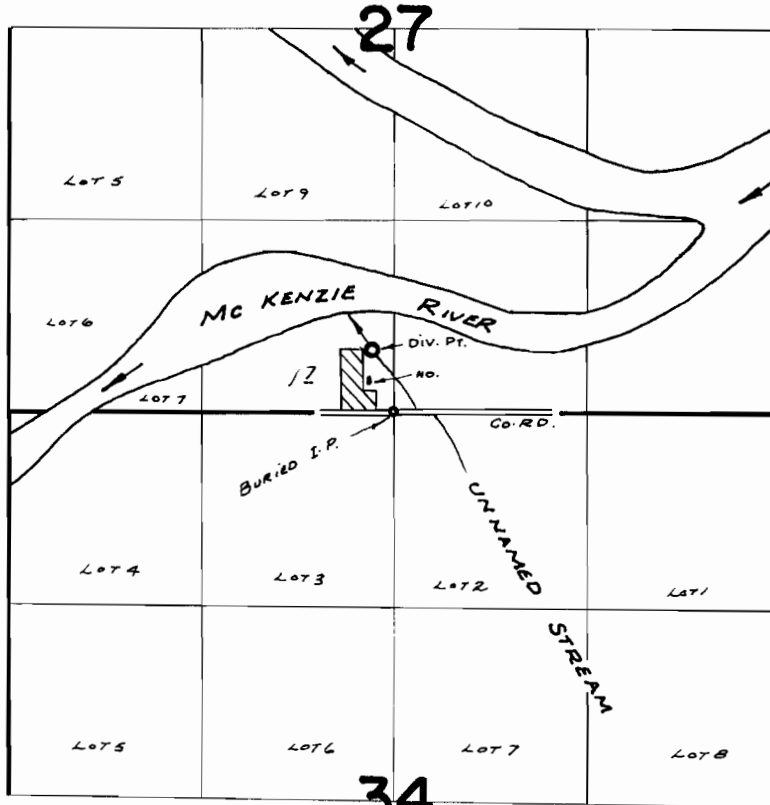

DIV. PT. Loc: 425' N. & 150' W. FROM S. 1/4 COR. SEC. 27

CIVIL ENGINEERING

44944

33591

GEORGE R. HARLOW

OCT. 14, 1970

R. MUCKEN