


T. 16 S. R. 2 W. W. M.

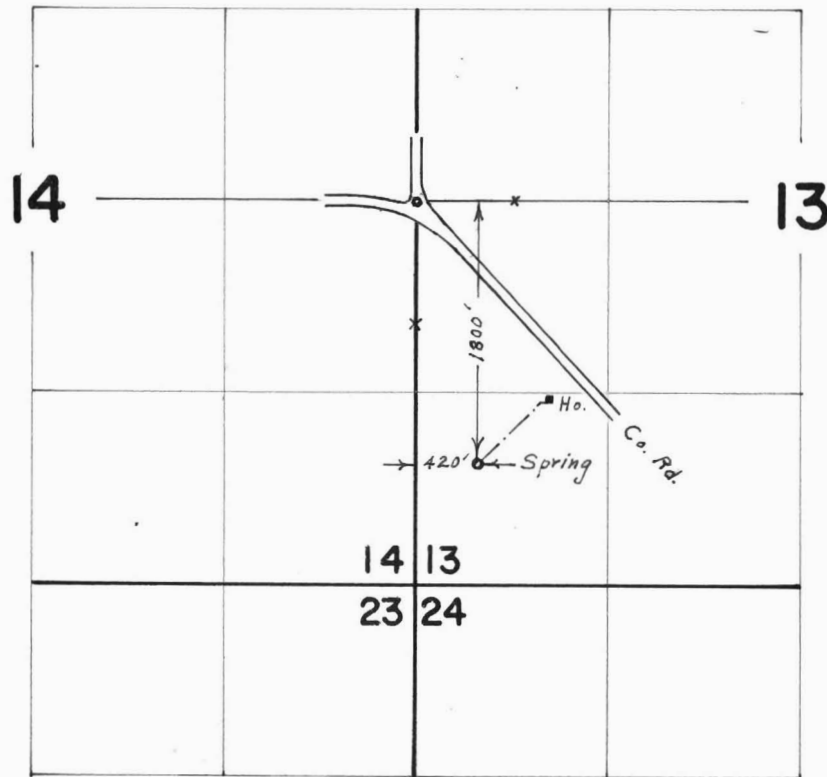

FINAL PROOF SURVEY

UNDER

Application No. 45516 Permit No. 33789

IN NAME OF

CHARLES H. LYONS

Surveyed June 17, 1970, by L. E. Gould