


# T.17S.R.IW.W.M.

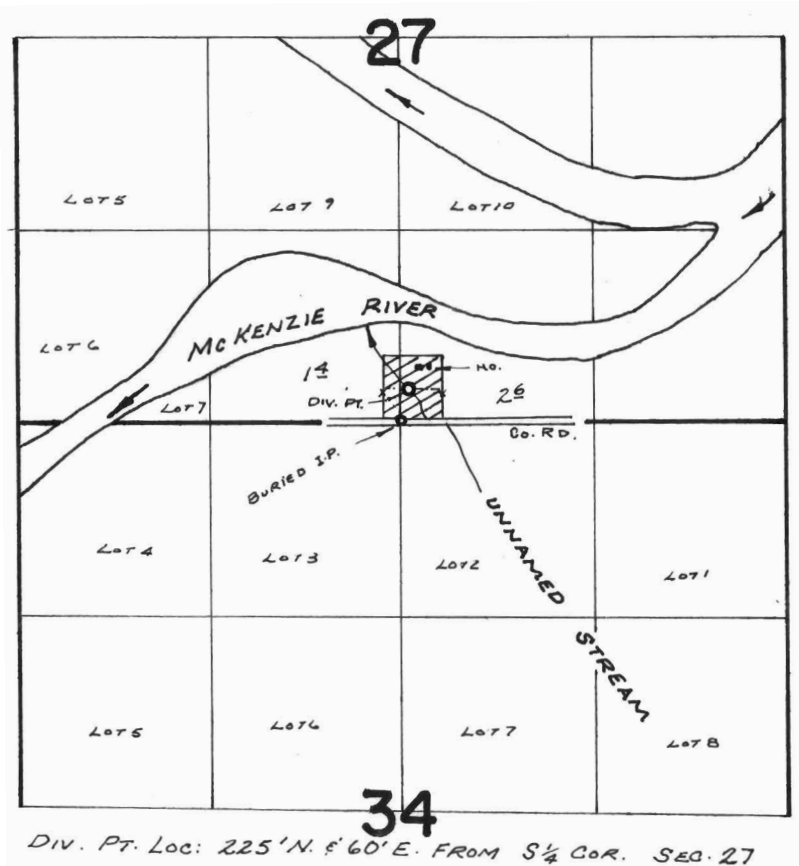

## FINAL PROOF SURVEY

UNDER

Application No. 46435 Permit No. 34694

IN NAME OF

THOMAS J. & CATHRYN BENSON

Surveyed OCT. 14, 1970, by R. MUCKEN