


# T.11S.R.2W.W.M.

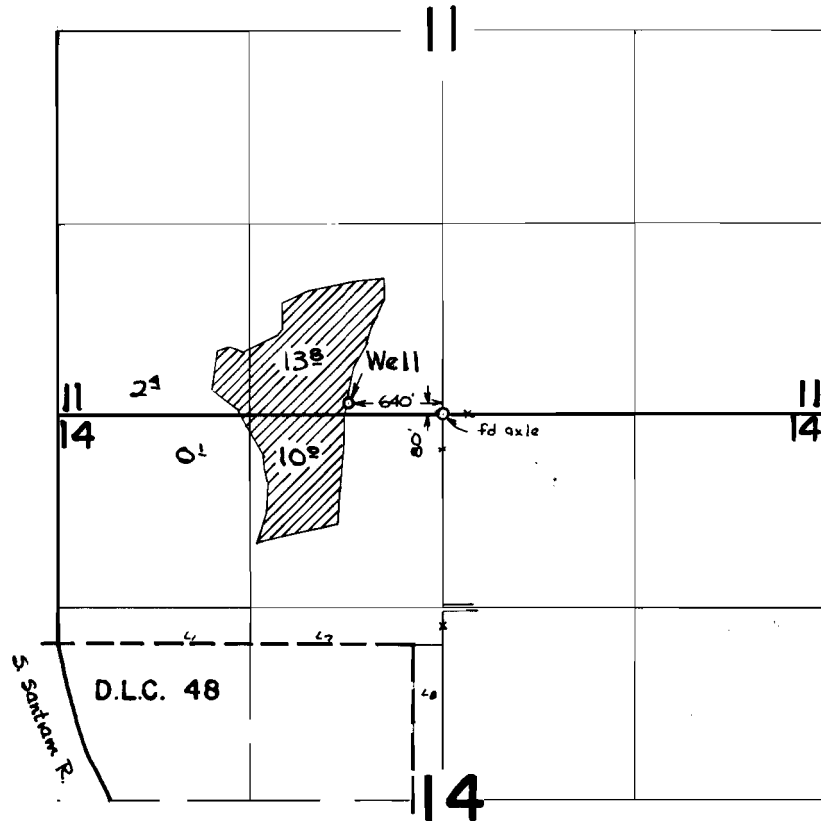

## FINAL PROOF SURVEY UNDER

Application No. G 3593 Permit No. G 3381  
IN NAME OF

VERNON & HELEN SNODDY

Surveyed 28 JULY 1970, by D.R. BUELL