


T.11S.R.2W.W.M.

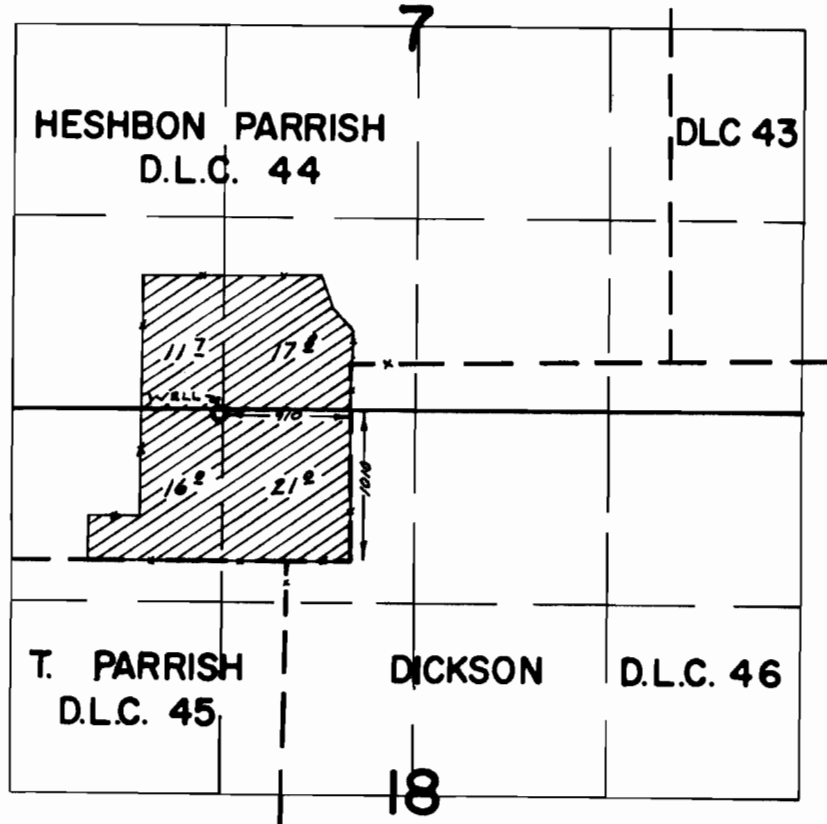

FINAL PROOF SURVEY UNDER

Application No. G.-4398 Permit No. G.-4146
IN NAME OF

JAMES W. & AUDREY L. COOK

Surveyed MAY 28, 1970, by R. MUCKEN