


T.9 & 10S.R.1W. W.M.

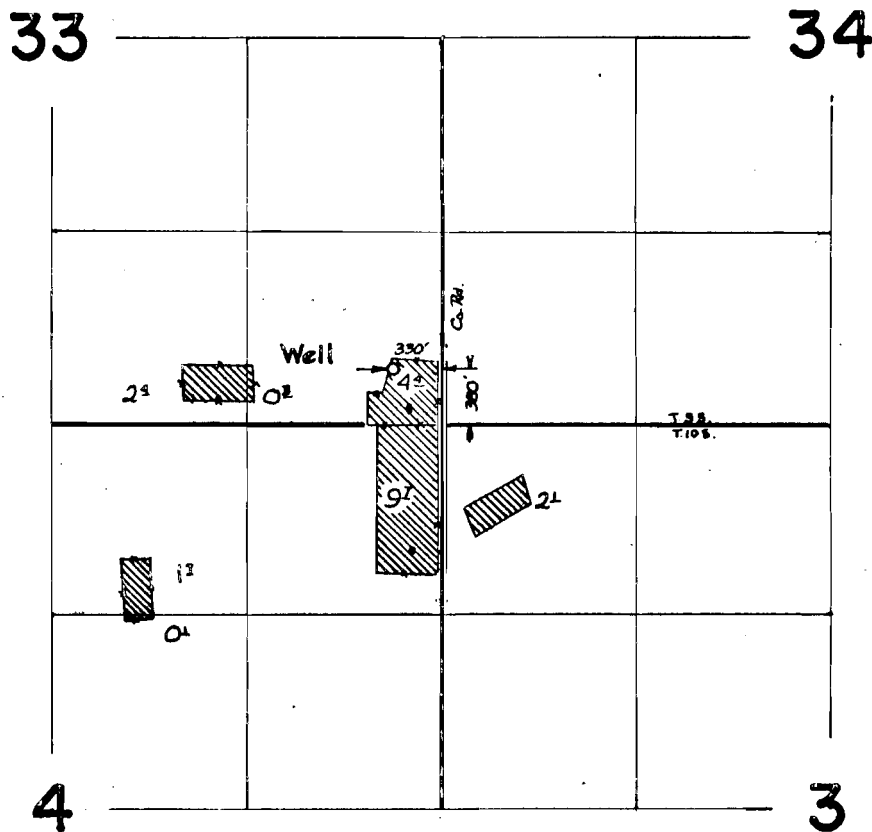

FINAL PROOF SURVEY

UNDER

Application No. G 4445 Permit No. G4191

IN NAME OF

JERALD & JOYCE BASL

Surveyed 7 JULY 1970, by D. R. BUELL