


T.10 & 11 S. R.2 W. W.M.

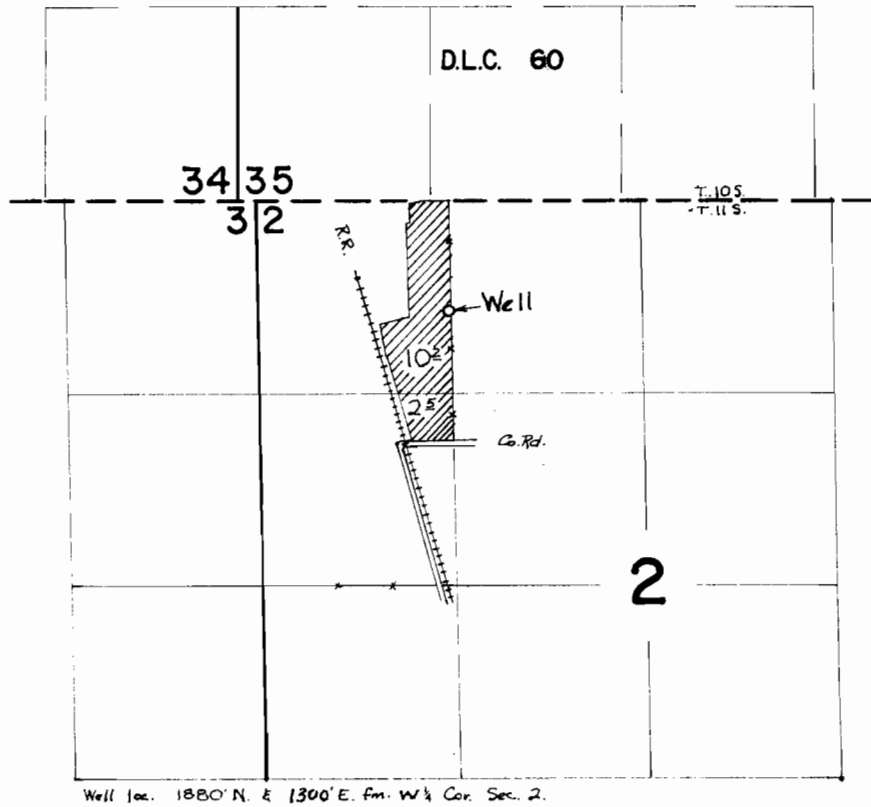

FINAL SURVEY

G 4544

G 4274

BISHEDRU INC.

7 JULY 70

D. R. BUELL