


T. I4S.R.IW.W.M.

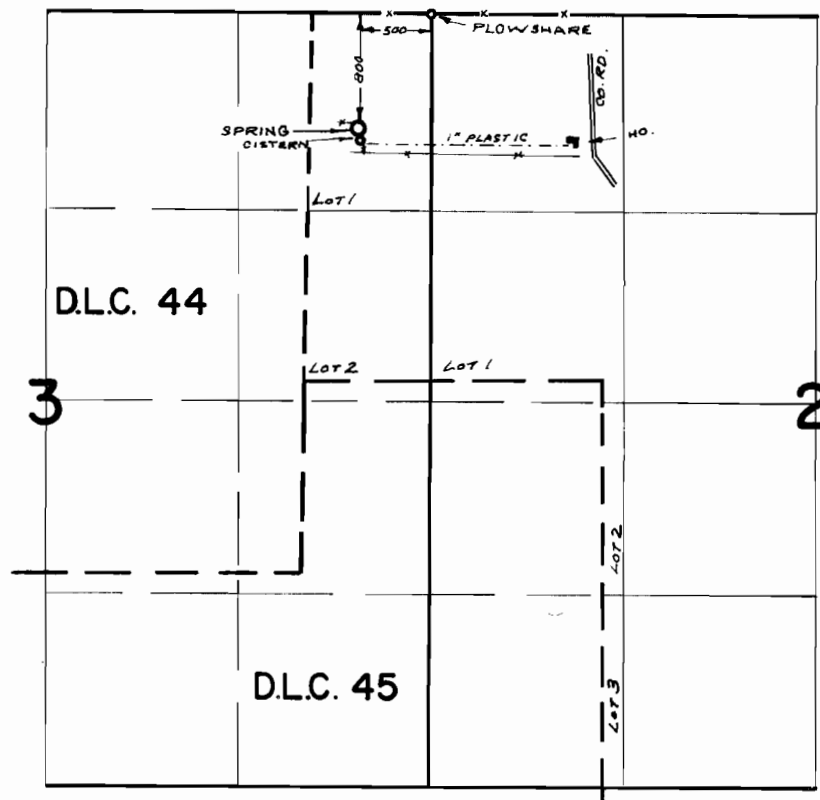

FINAL PROOF SURVEY
UNDER

Application No. 4/459... Permit No. 30954...
IN NAME OF

OWEN BROWN

Surveyed JULY 8, 1970, by R. MUCKEN...