


# T.I.O.S.R.I.E.W.M.

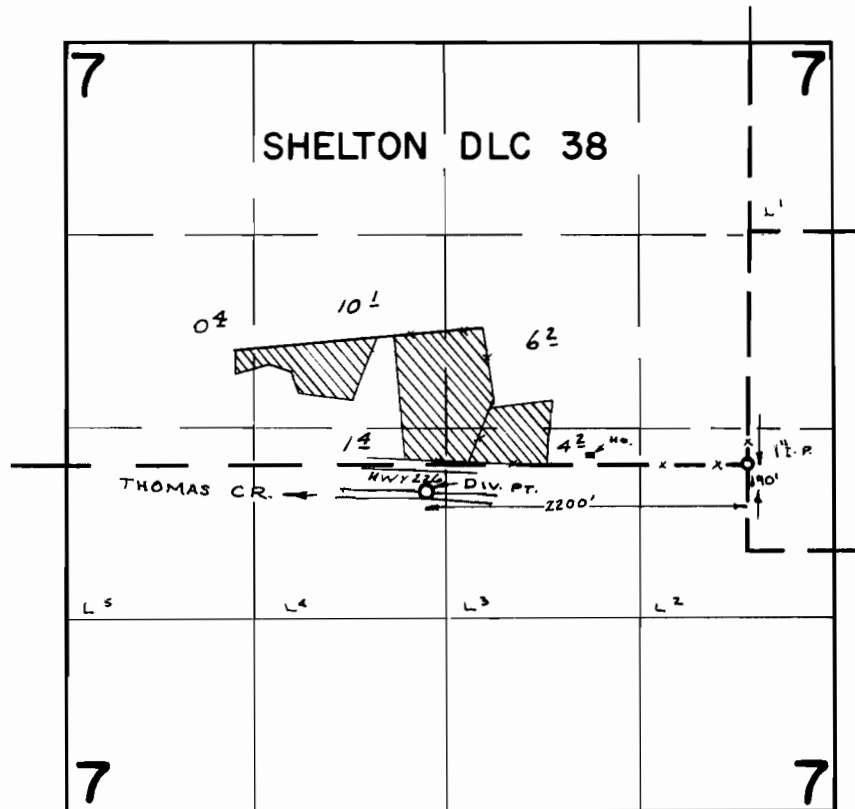

## FINAL PROOF SURVEY UNDER

Application No. 41872 Permit No. 31326  
IN NAME OF

ALLAN M. OLDS

Surveyed MAR. 27, 1970, by R. MUCKEN