


T.9S.R.IW.W.M.

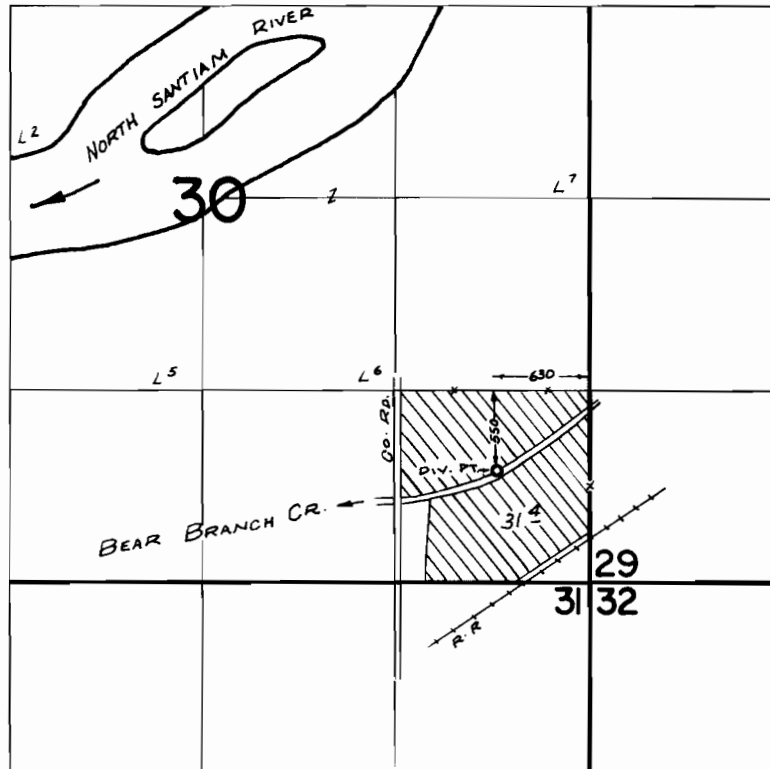

FINAL PROOF SURVEY
UNDER

Application No. 43069 Permit No. 31950
IN NAME OF

JOE J. & MAXINE J. SLANGAL

Surveyed MAY 4, 1970, by R. MUCKEN