


T. 11 S. R. 1 W. W.M.

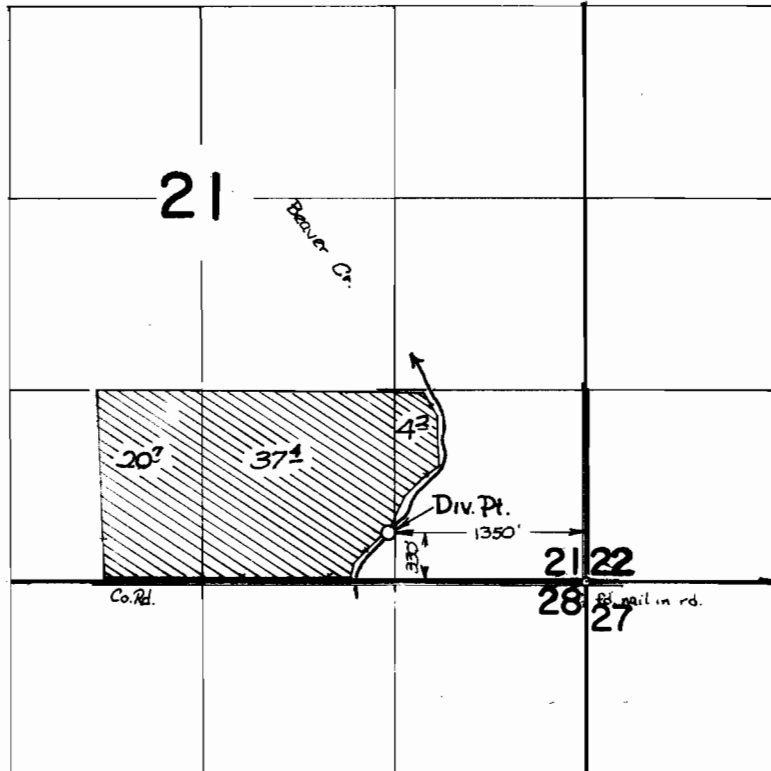

FINAL PROOF SURVEY

UNTER

Original No. 43084 Sub No. 32187

NAME OF

BERT E. & JUNE M. SMEE

Surveyed 30 JULY 19 70 by D. R. BUELL