


T. 11S. R. 14W. W.M.

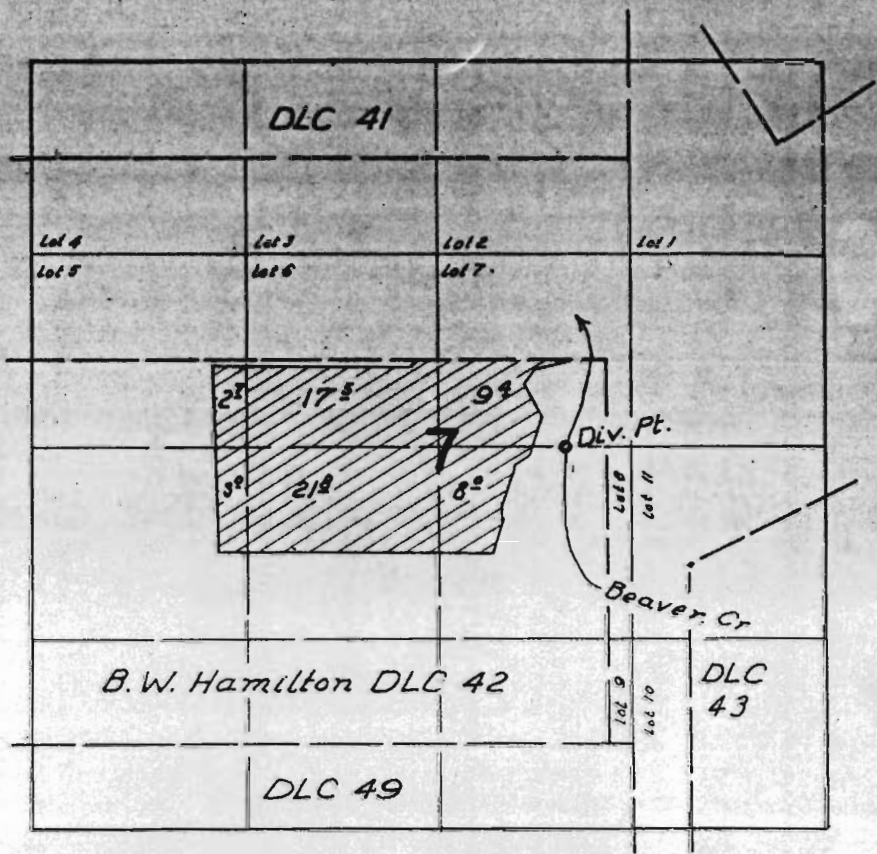

app. no. 43342
per. no. 30396

FINAL PROOF SURVEY

Application No. 29189 Permit No. 22949

IN NAME OF
R.C. Draper

Surveyed Sept. 1 1959, by R.H. Jackson