


T.I.O.S.R.I.W.W.M.

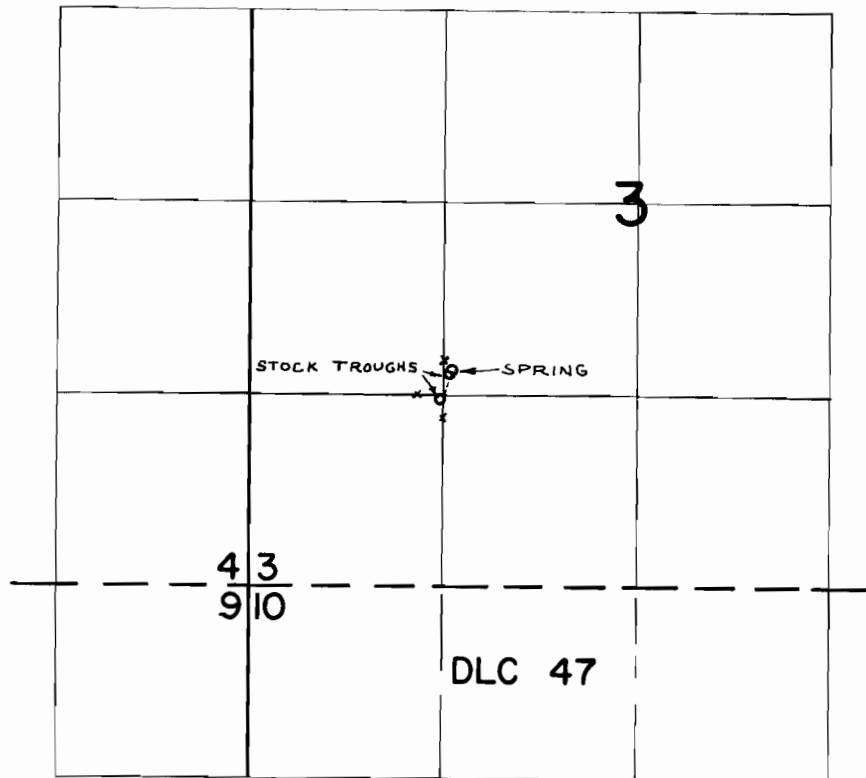

SPRING LOCATED : 60' E. & 170' N. FROM NE. COR. SE⁴ SE⁴ SEC. 3

FINAL PROOF SURVEY
UNDER

Application No. 43363 Permit No. 32409
IN NAME OF

CARL LIMBECK

Surveyed MAR. 31, 1970, by R. MUCKEN