


# T.12 S. R.1 W. W.M.

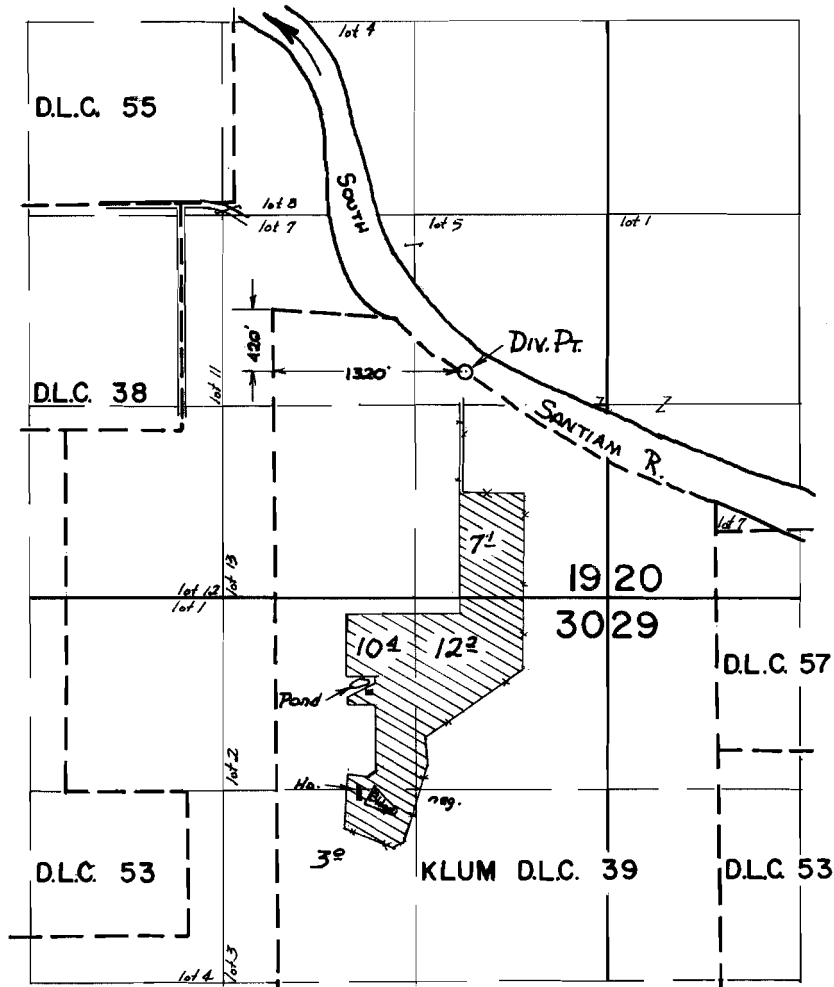

## FINAL PROOF SURVEY UNDER

Application No. 43430 Permit No. 32470  
IN NAME OF

JOE H. & IDA M. REGIMBAL

Surveyed 9 JULY 1970, by R. MUCKEN