


T.IOS.R.IW. & IE.W.M.

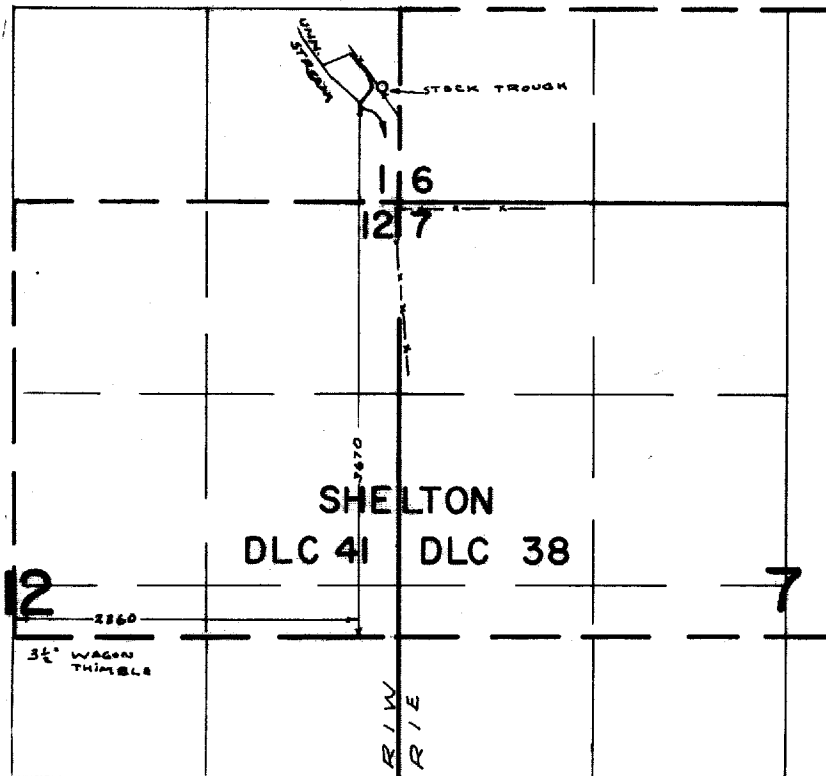

FINAL PROOF SURVEY UNDER

Application No. 3770 Permit No. 32667
33627 IN NAME OF
HAFCO INC.

Surveyed MAR. 27, 1970, by R. Mucken