


T.9S.R.IW.W.M.

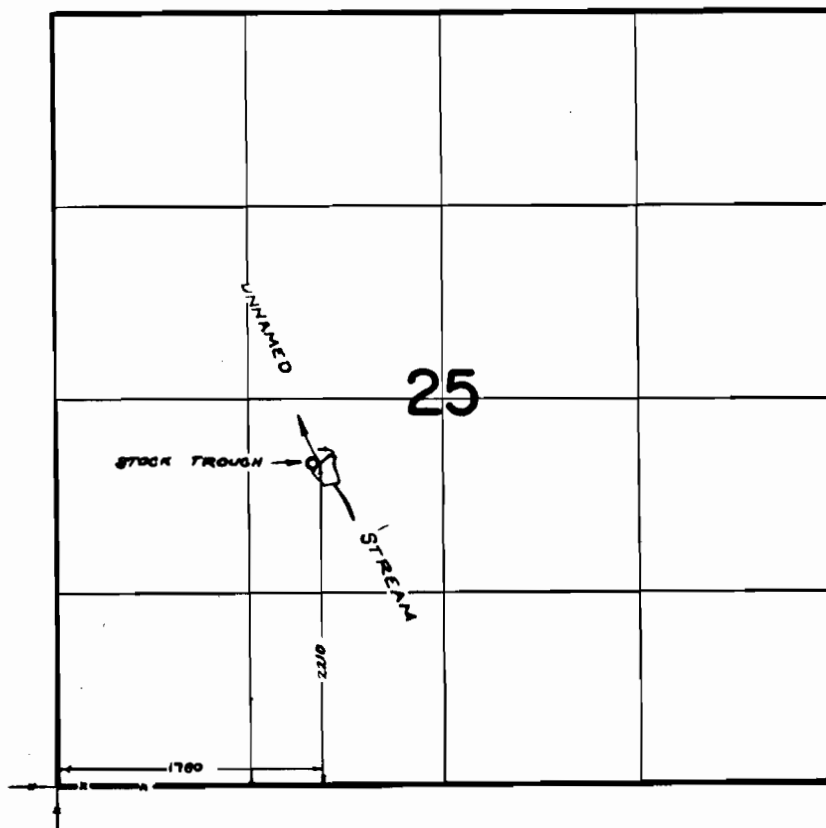

FINAL PROOF SURVEY
UNDER

Application No. R-44264 Permit No. R-5086
44265 38936
IN NAME OF

FRANCES KREILICH

Surveyed MAY 6, 1970, by R. MUCKEN