


# T.9S.R.IW.W.M.

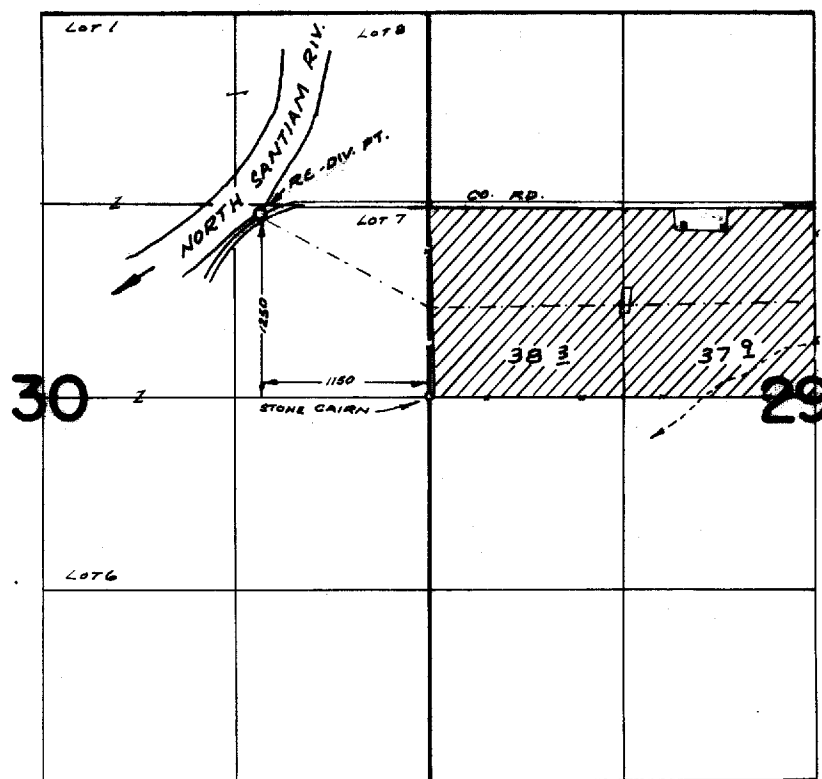

## FINAL PROOF SURVEY UNDER

Application No. 44663 Permit No. 33442  
IN NAME OF

GEORGE J. ROLFE

Surveyed APR. 22, 1970. by R. MUCKEN.