


T.13S.R.1E.W.M.

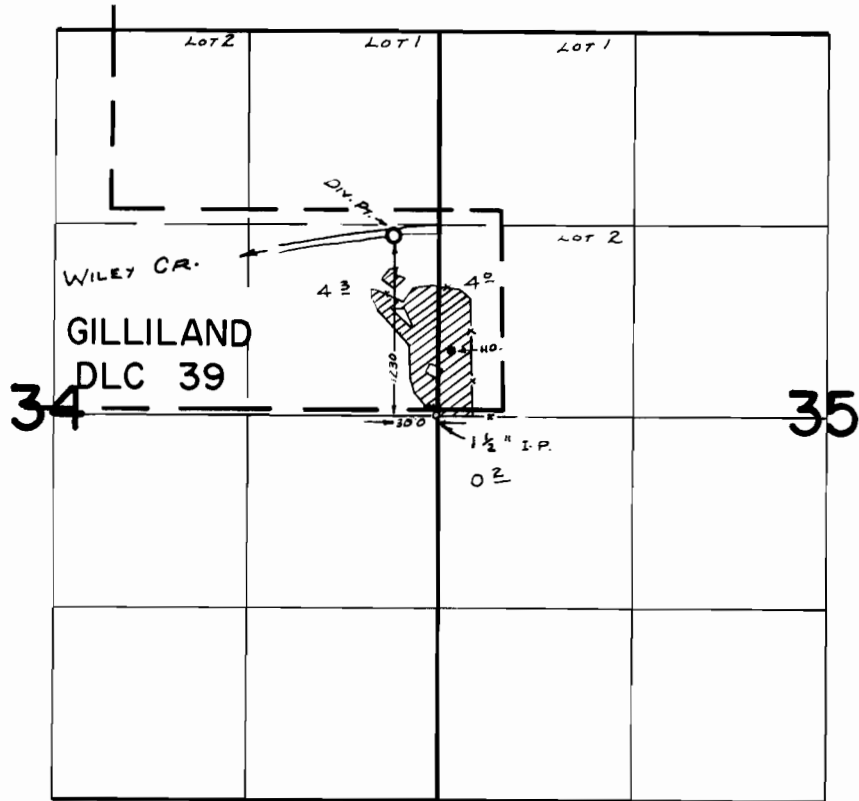

FINAL PROOF SURVEY UNDER

Application No. 44296 Permit No. 33578
IN NAME OF

ELENORE PECK PHILLIPS

Surveyed MAR. 24. 1970, by R. MUCKEN.