


T.13S.R.1E.W.M.

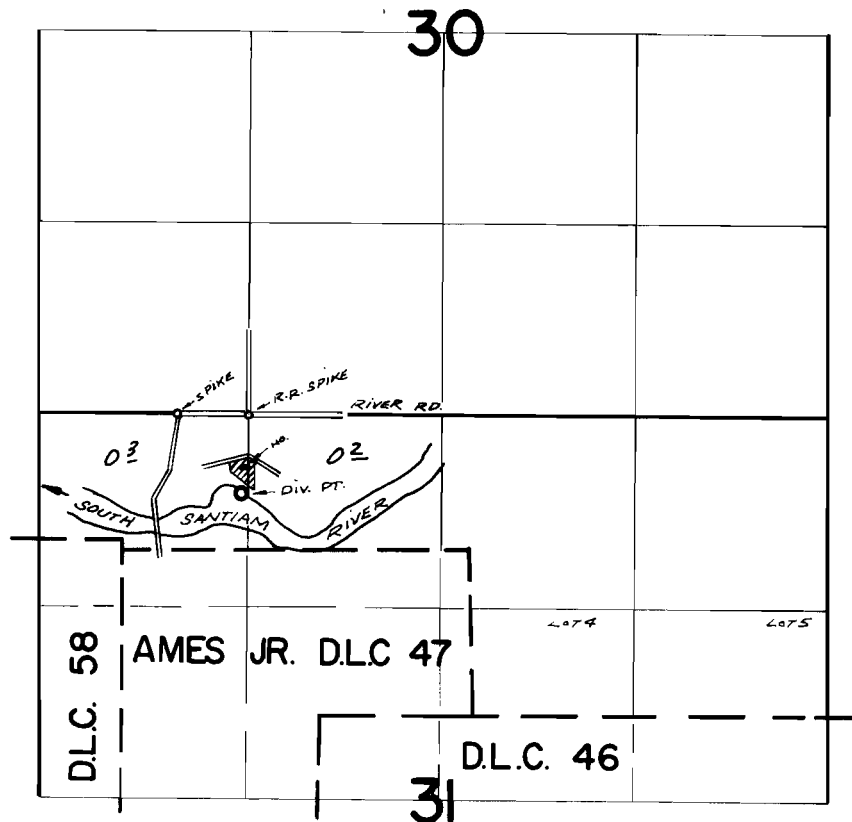

DIV. PT. LOC: 530'S. & 40' W. FROM N.E. COR. NW & NW 1/4 SEC. 31

FINAL PROOF SURVEY
UNDER

Application No. 45831 Permit No. 34219
IN NAME OF

QUENTIN J. BAITINGER

Surveyed MAR. 25, 1970, by R. MUCKEN.