T.8S.R.3W.W.M.

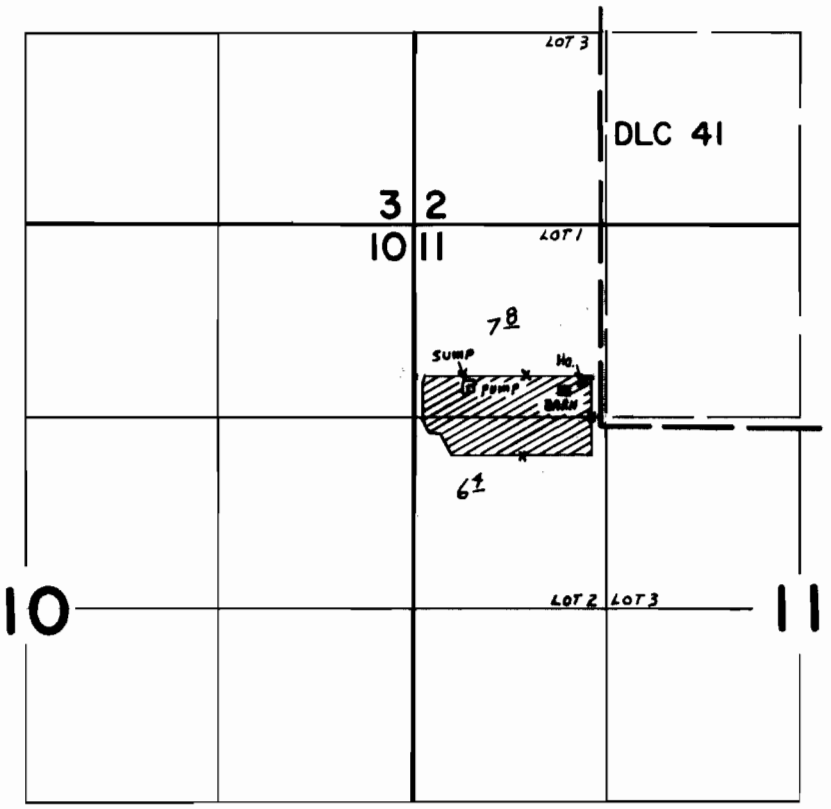

SUMP WELL LOC. 1111' S. & 390' E. FROM N.W. COR. SEC. 11

FINAL PROOF SURVEY
UNDER

Application No. G-1876 Permit No. G-1591
IN NAME OF

LEO F. ELSER & ROSE M. ELSER

Surveyed SEPT. 25 19 70, by L. E. GOULD

GB
1970-W