


T.6S.R.3W.W.M.

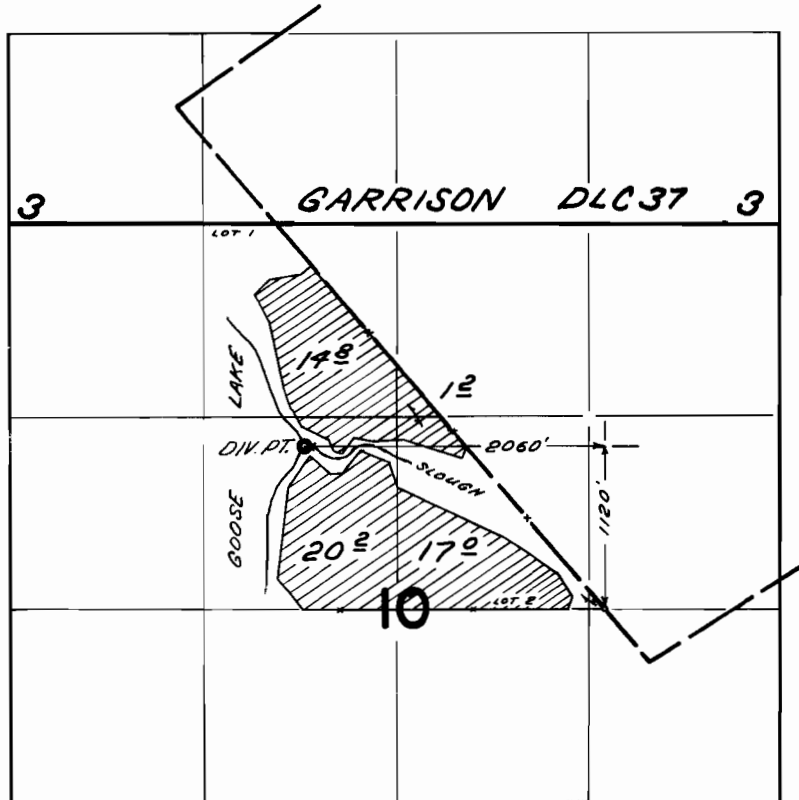

FINAL PROOF SURVEY
UNDER

Application No. 41416 Permit No. 30935
IN NAME OF

JOHN H. FASNACHT

Surveyed Nov. 20 & 21, 1967, by W. J. RUPPERT
Insp. Sept. 27 1971, by R. G. Mucken