


based on legal with
correct file 41781
appears wrong

T. 6S. R. 1W. W.M.

TO TOM:
In relationship to
the tie, it appears
that also this map is
file 41781 it appears
must not be sections
drafted standard is
correct

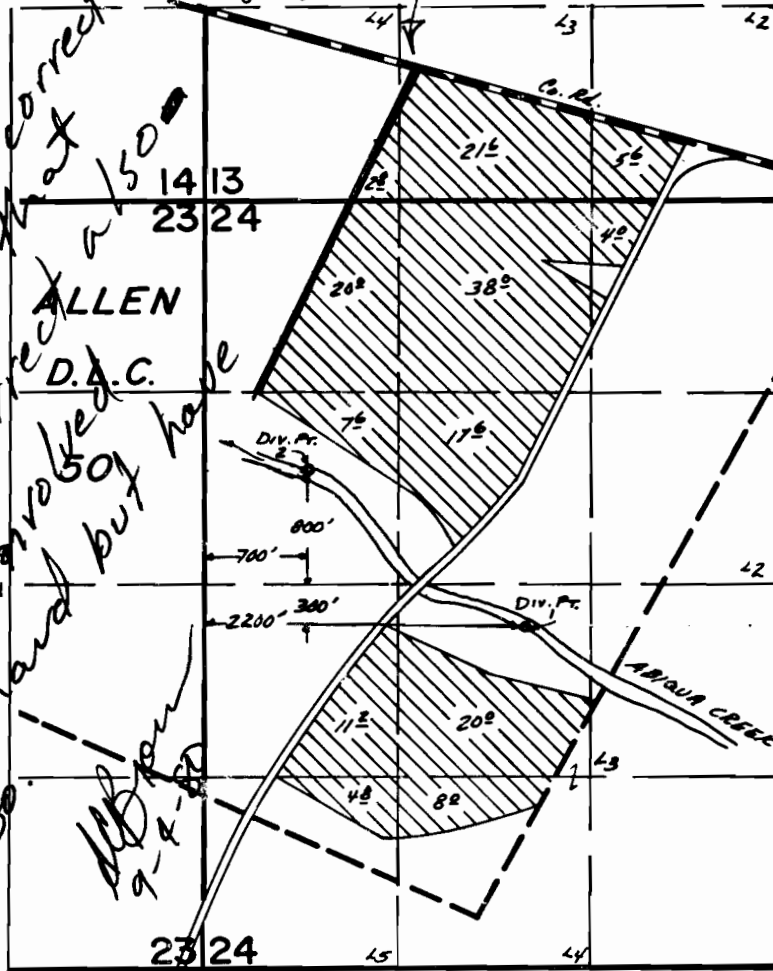

FINAL PROOF SURVEY
UNDER

Application No. 53924... Permit No. 40232...
IN NAME OF

MOUNT ANGEL ABBEY.....

Surveyed Oct. 12, 1978, by J.S. Donaldson..

~~~~~  
~~~~~  
~~~~~

MM