


T. 14 S. R. 5 W. W. M.

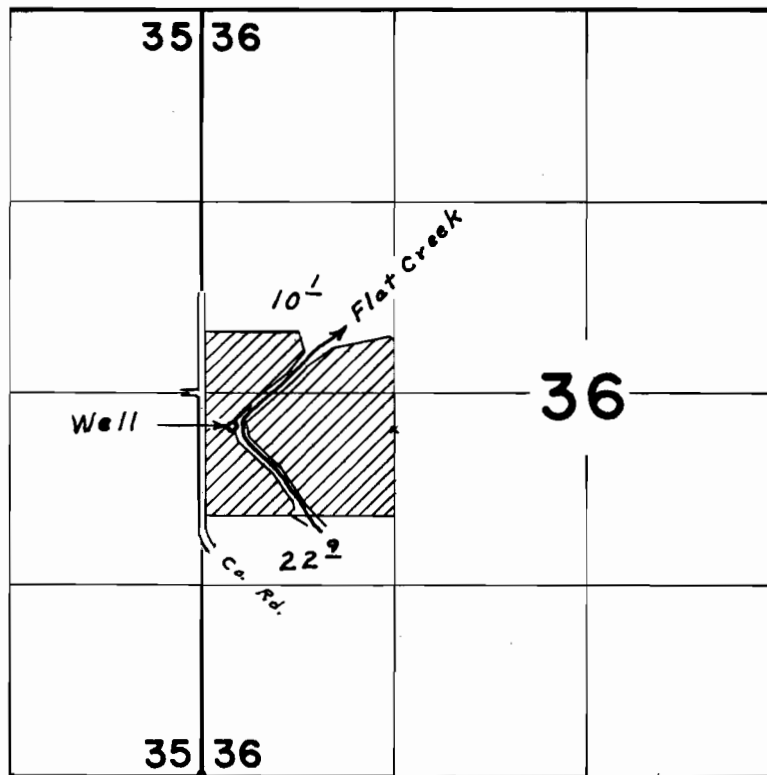

Well located 2420' N. & 210' E. from S.W. Cor. Sec. 36

## FINAL PROOF SURVEY

UNDER

Application No. G-3255 Permit No. G-3051

IN NAME OF

NORMAN W. MILLER

Surveyed May 6, 1970, by L. E. Gould