


T. 14 S. R. 5 W. W. M.

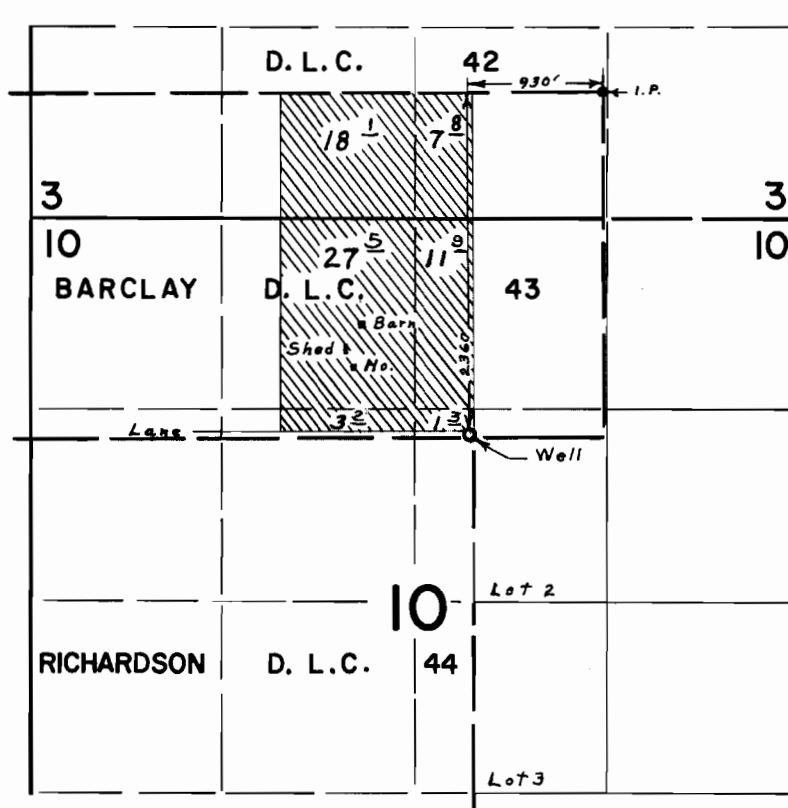

FINAL PROOF SURVEY UNDER

Application No. G-3497 Permit No. G-3294
IN NAME OF

CROCKER BROTHERS

Surveyed March 27, 1970, by L. E. Gould